


T.6S. R.1W. W.M.

MARION COUNTY

ELIAS COX DLC 43

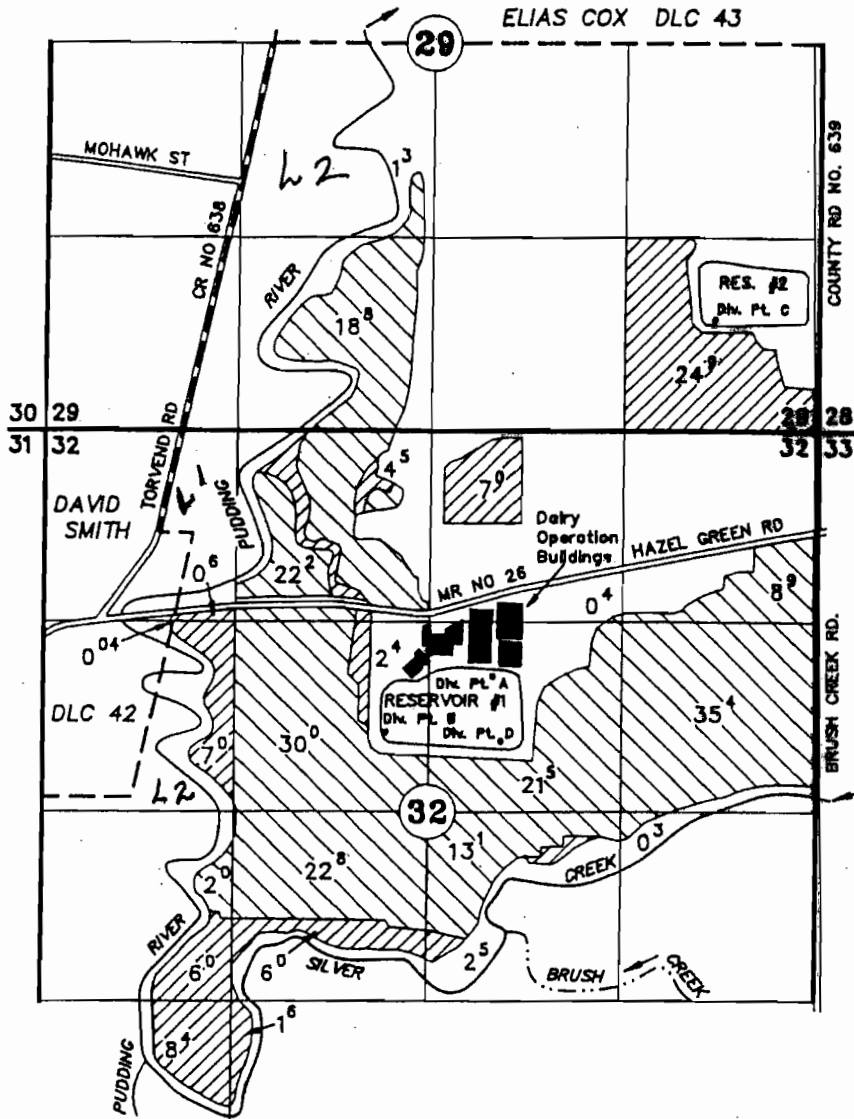

DIV. PT. A: DAIRY OPERATION - 2230' W AND 1740' S OF NE COR. SEC. 32.
 DIV. PT. B: IRRIGATION - 2990' W AND 2080' S OF NE COR. SEC. 32.
 DIV. PT. C: IRRIGATION - 710' W AND 800' N OF SE COR. SEC. 29.
 DIV. PT. D: IRRIGATION - 2140' W AND 2150' S OF NE COR. SEC. 32.

FINAL PROOF SURVEY RECEIVED UNDER


OCT 01 1999

Application No.	18808 18849 22552 24801 43004 R-71810 R-71914 71913	Permit No.	14448 14483 17759 19930 32129 R-11533 R-11834 81594
-----------------	--	------------	--

WATER RESOURCES DEPT.
SALEM, OREGON

MALLORIES DAIRY INC.

SEPTEMBER 17, 1999
SCALE: 1" = 1320'

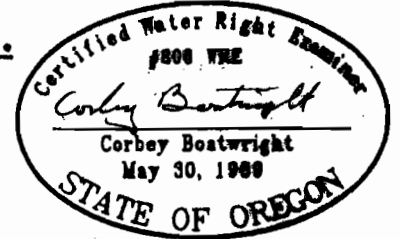

NOTE: This map is for the purpose of identifying the location of water rights and has no intent to dimension or locate property ownership lines.

Amended by WRD Staff, 12-12-2008, wj