


FINAL PROOF SURVEY

Located in the NW 1/4 of Section 34,
Township 29 South, Range 11 West, W.M.
Coos County, Oregon
TL 1700

RECEIVED

SEP 29 1997

WATER RESOURCES DEPT.
SALEM, OREGON

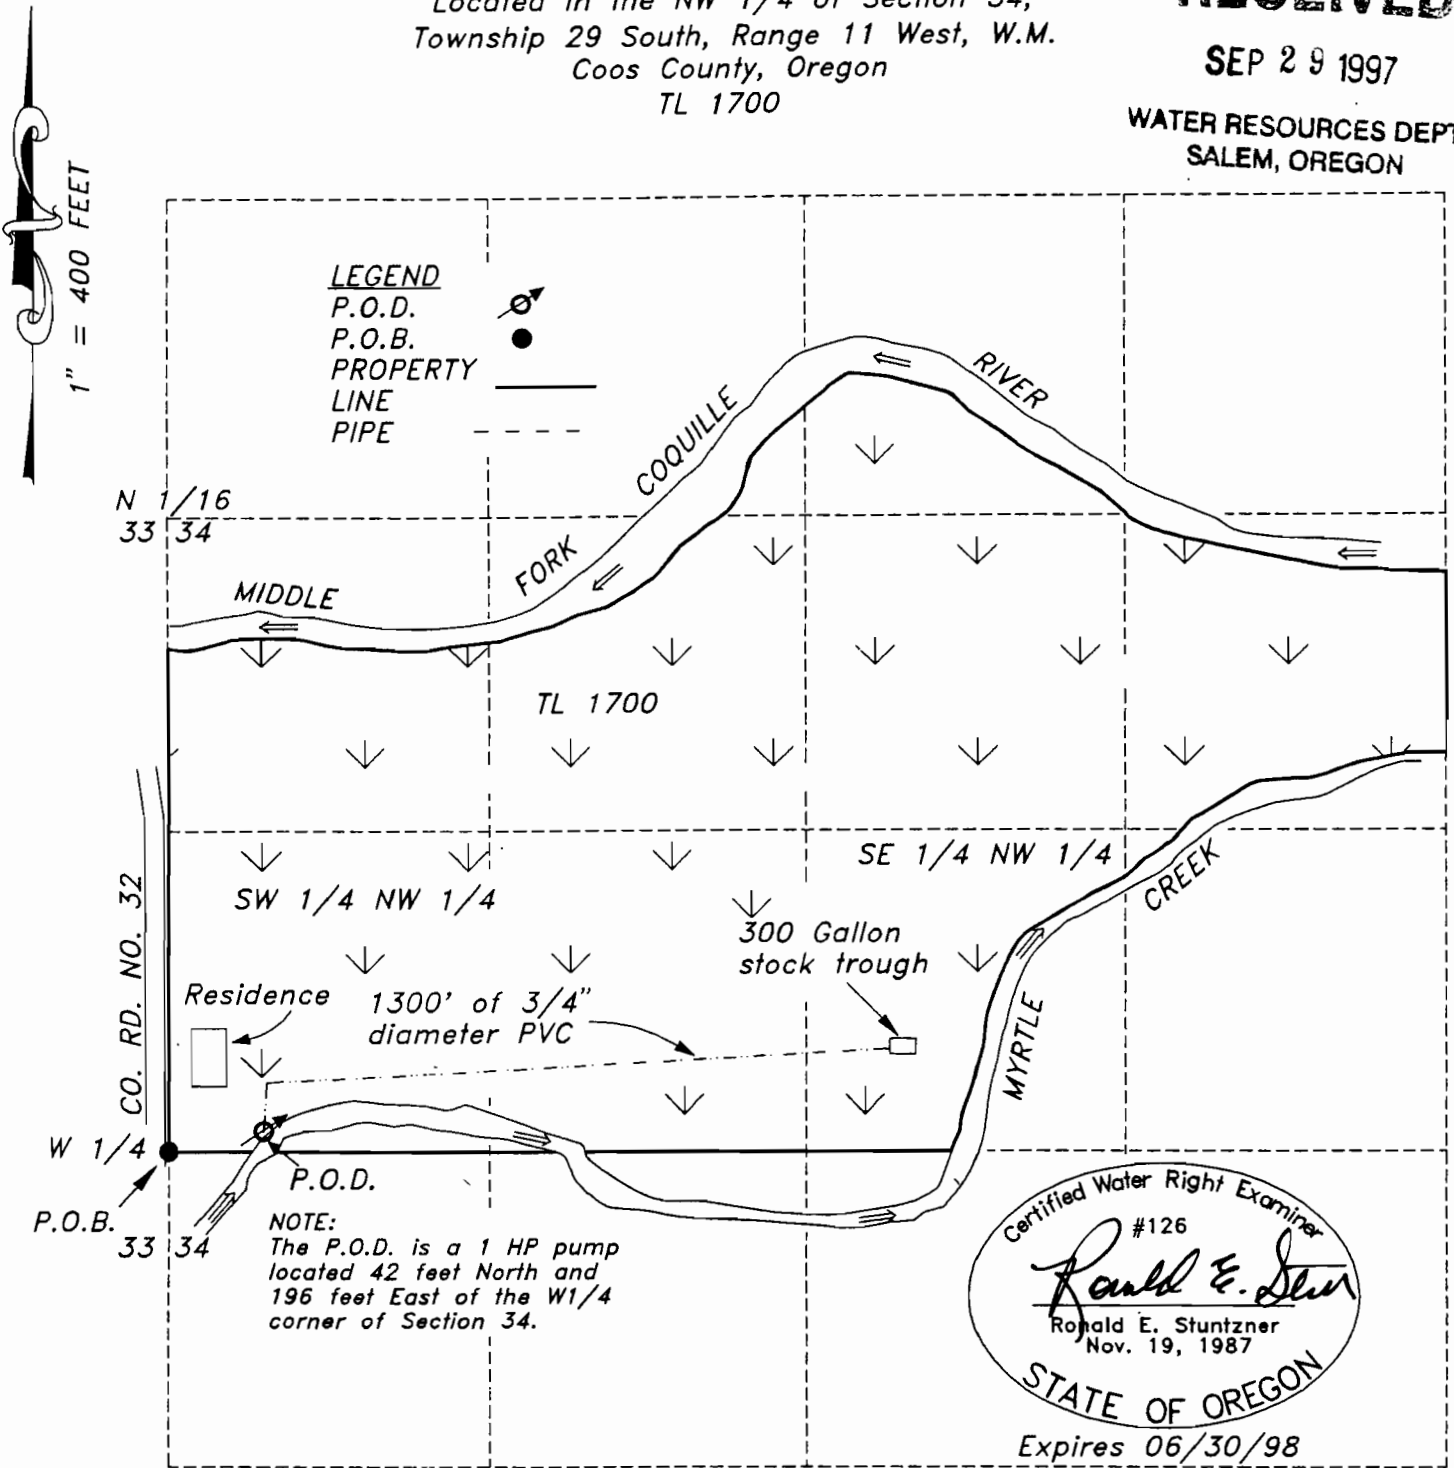

NOTE:
The P.O.D. is a 1 HP pump
located 42 feet North and
196 feet East of the W1/4
corner of Section 34.

Certified Water Right Examiner
#126
Ronald E. Stuntzner
Ronald E. Stuntzner
Nov. 19, 1987
STATE OF OREGON
Expires 06/30/98

Prepared For: Steve Martinez
Prepared By: Dennis Goude
Date Prepared: September 15, 1997

Application No. 73731
Permit No. 52116

**Stuntzner Engineering
& Forestry, LLC**
ENGINEERING * LAND SURVEYING * FORESTRY
PLANNING * WATER RIGHTS
705 South 4th St.
Post Office Box 118
Coos Bay, Oregon 97420
Phone (541) 267-2872
Fax (541) 267-0588

EXAMINERS DISCLAIMER STATEMENT
The preparation of this map was for the purpose of
identifying the location of the Water Right only and
has no intent to provide dimensions or location of
property ownership lines.