


T.1S.,R.12E,WM.

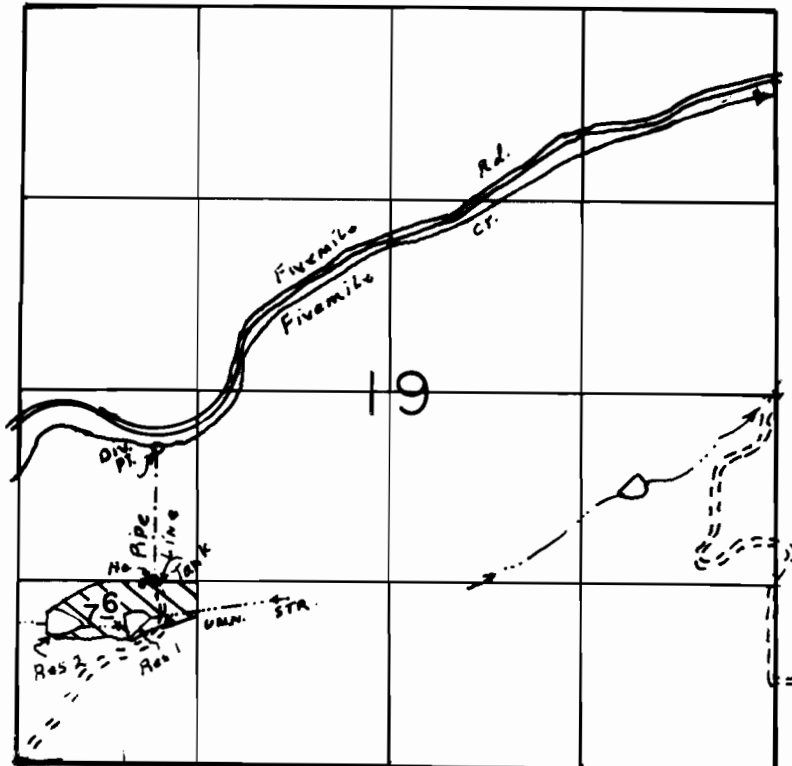

DIV.PT.LOC: 2180' N & 950' E FROM SW COR. OF SEC 19.
DAM 1: 900' N & 750' E DAM 2: 950' N & 200' E

SCALE: 1" = 1320'

FINAL PROOF SURVEY UNDER

Application No. R-57562 Permit No. R-7790...
IN NAME OF

DENNIS D. TRIBBY

Surveyed JUNE 26 1995, by R.M. SUTTERFIELD