


T.1S., R.12E., W.M.

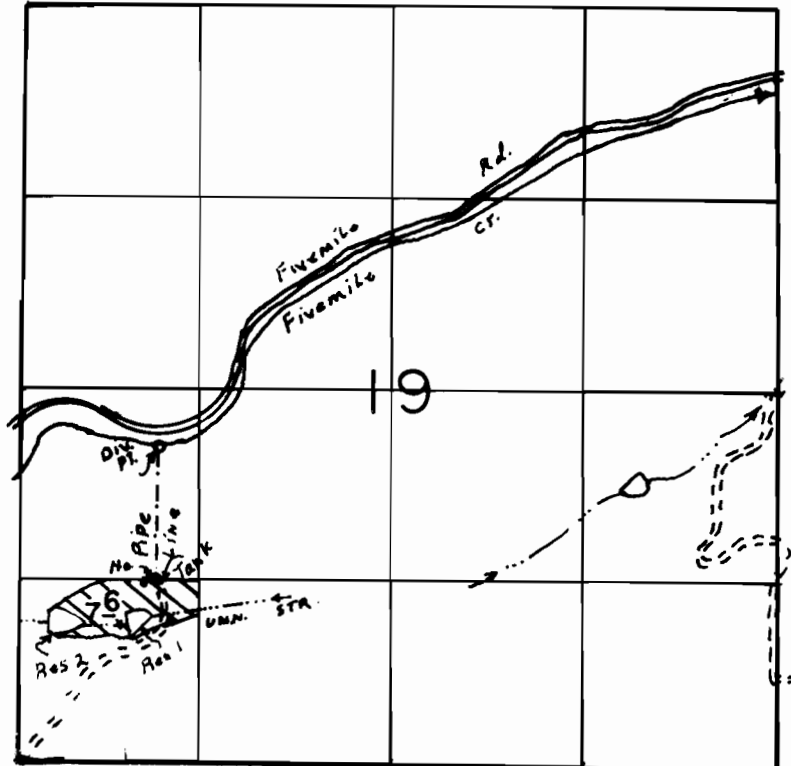

DIV. PT. LOC: 2180' N & 950' E FROM SW COR. OF SEC 19.
DAM 1: 900' N & 750' E DAM 2: 950' N & 200' E

SCALE: 1" = 1320'

FINAL PROOF SURVEY
UNDER

Application No. R-57562 57562 43874
Permit No. R-7790...
IN NAME OF

DENNIS D. TRIBBY

Surveyed JUNE 26 1995, by R.M. SUTTERFIELD