


T. 39 S., R. 8 W., W.M.

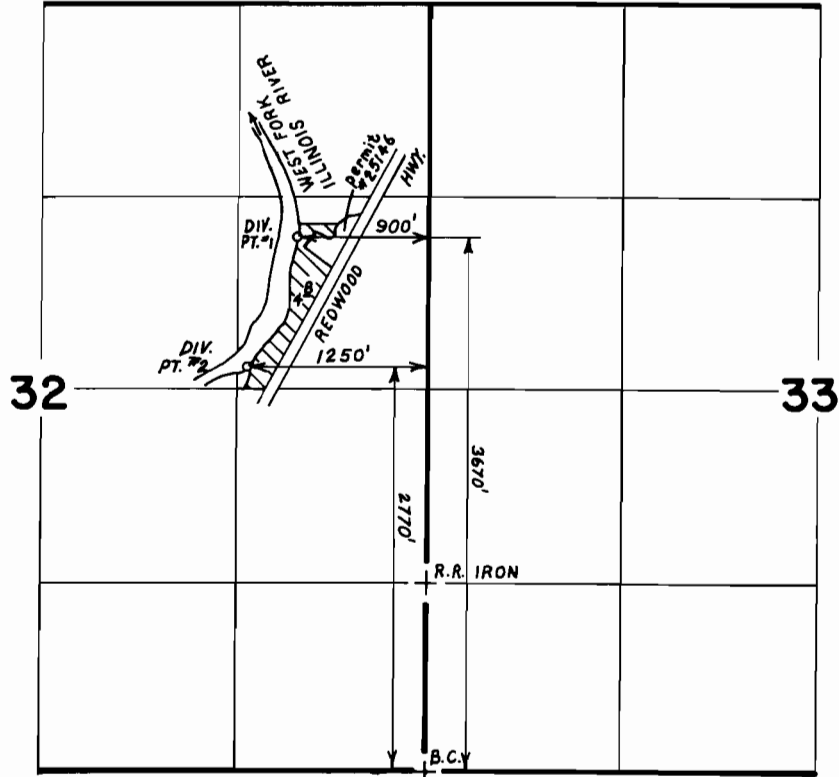

SCALE: 1" = 1320'

FINAL PROOF SURVEY UNDER

Application No. 50125... Permit No. 37132.....
IN NAME OF

.....
Surveyed MAR. 27 1984, by B. S. JAMES.....