


T. 40 S., R. 9 W., W. M.

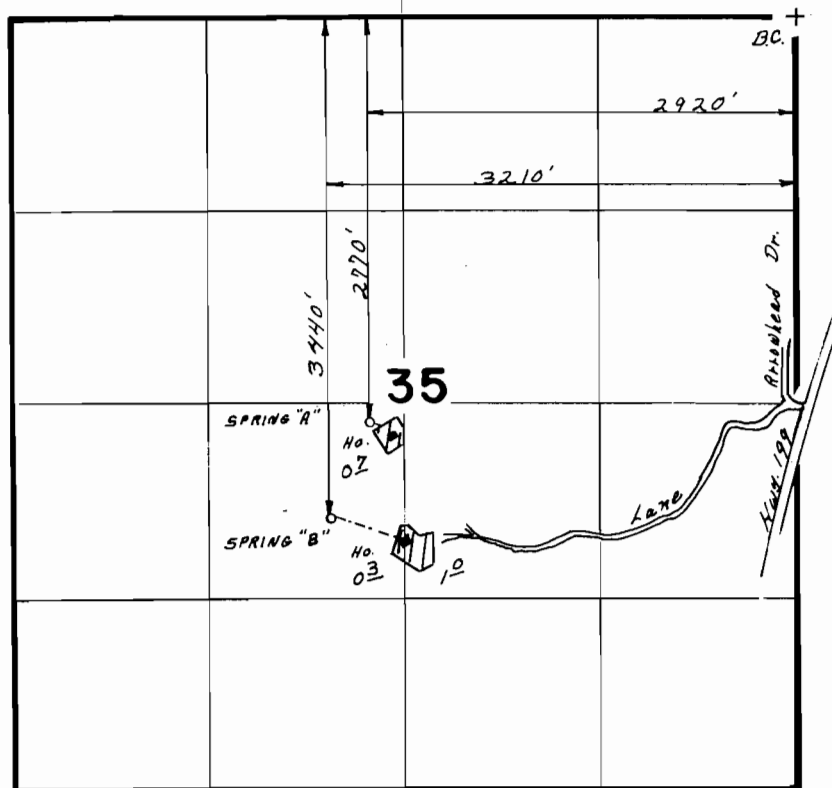

Scale: 1" = 1320'

FINAL PROOF SURVEY UNDER

Application No. 48834 Permit No. 36599
IN NAME OF

EUGENE MAJESKI & SYL ZUCKER

Surveyed APR. 8, 1986, by B. S. JAMES