


T. 35 S., R. 6 W., W. M.

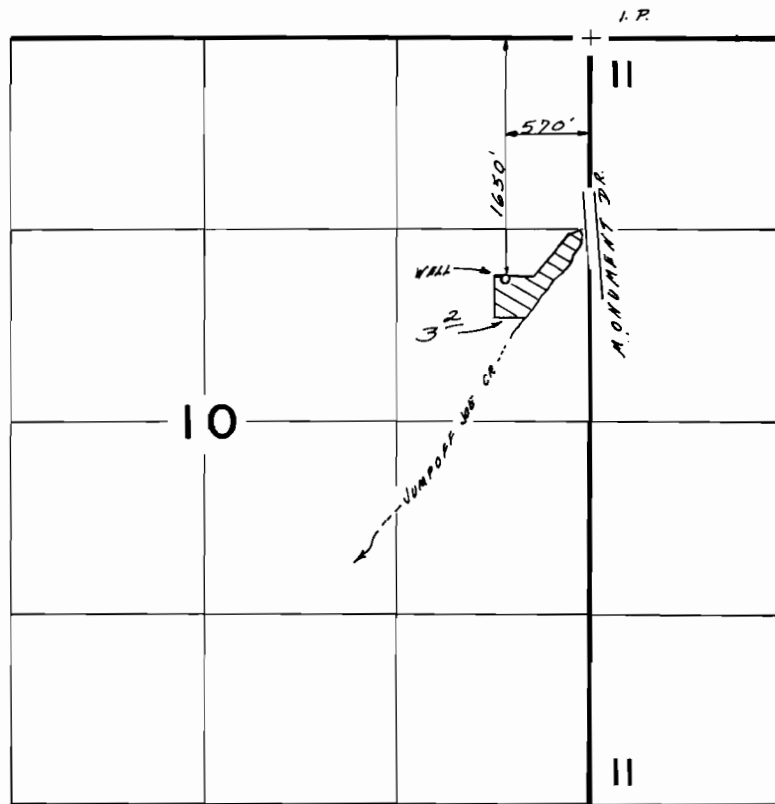

Scale: 1" = 1320'

FINAL PROOF SURVEY
UNDER

Application No. G-9396 Permit No. G-8744
IN NAME OF

R. DEAN BOWLES

Surveyed JUL. 16 1986, by B. S. JAMES