


T. 34 S., R. 5 W., W. M.

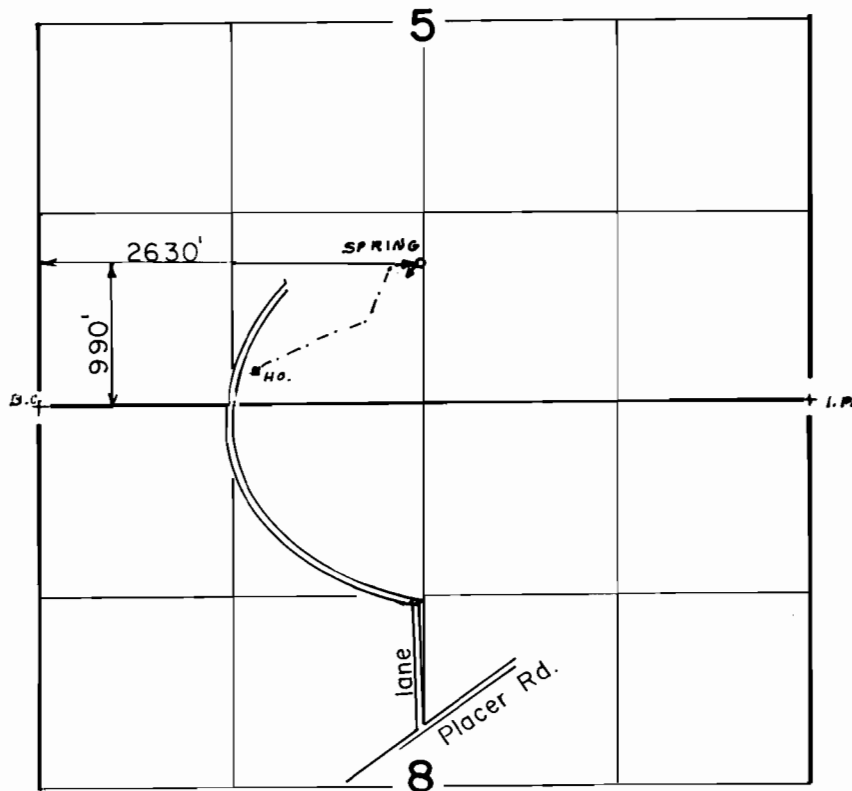

Scale: 1" = 1320'

FINAL PROOF SURVEY
UNDER

Application No. 48200 Permit No. 36203
IN NAME OF

SHEILA FERSON JENKINS

Surveyed AUG. 7, 1990, by B. S. JAMES