


T. 34 S., R. 1 W., W. M.

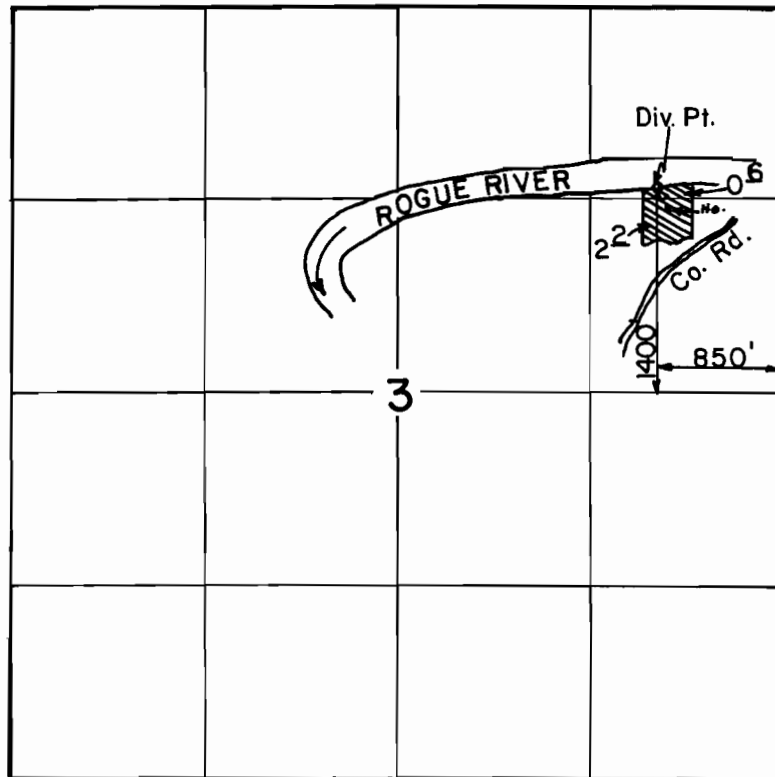

Scale: 1" = 1320'

FINAL PROOF SURVEY
UNDER

Application No. ~~5.48.15~~ Permit No. ~~4.11.2.4~~....
IN NAME OF

.....KATHERYN...F...BARBER.....

Surveyed JULY.16. 1991., by B..S...JAMES...