


T.39S., R.8W., W.M.

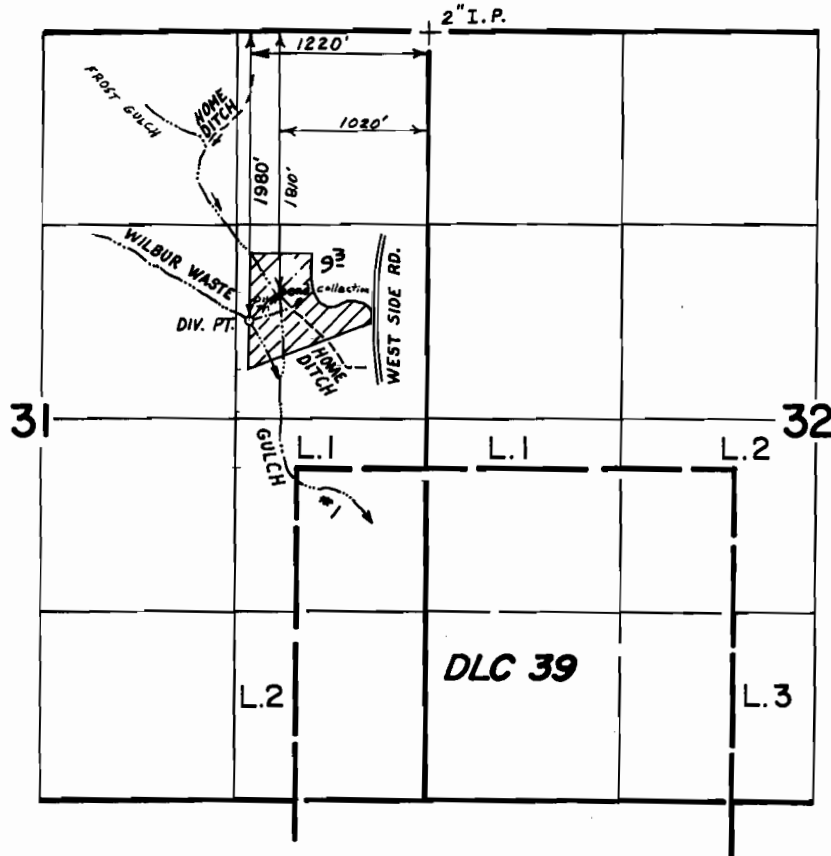

SCALE: 1"=1320'

FINAL PROOF SURVEY UNDER

Application No. **58536** Permit No. **44331**

IN NAME OF

DOUGLAS L. STOHLMAN

Surveyed **MAR. 28** 19**84**, by **B. S. JAMES**