


# T. 39S., R. 8W., W.M.



☒ TRANSFER NO. 4234

☒ TRANSFER NO. 4253

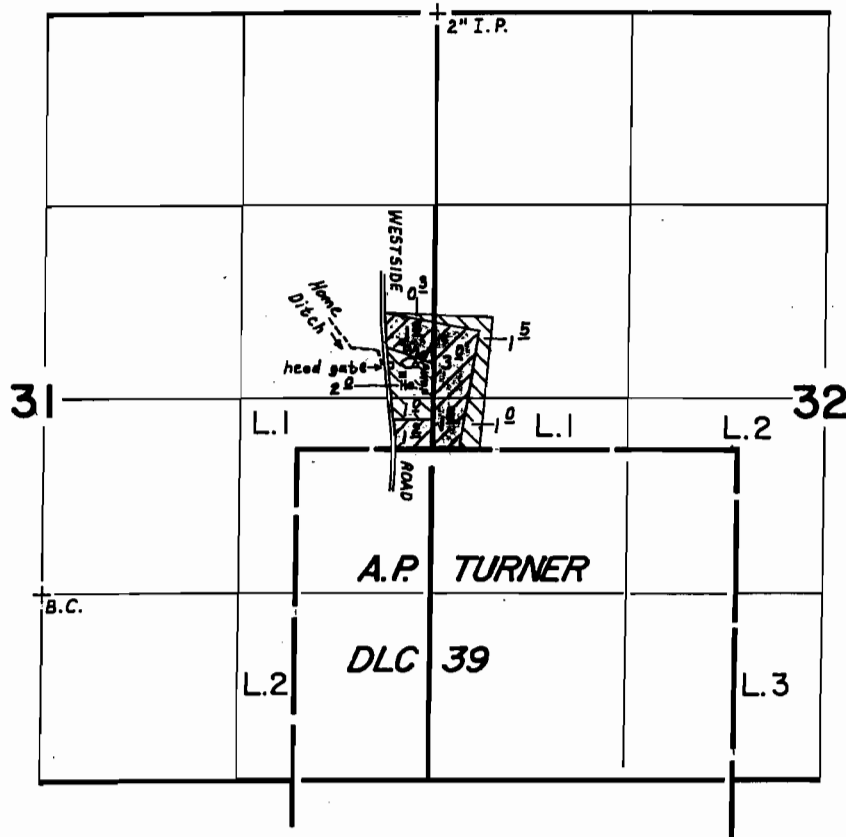

SCALE: 1" = 1320'

## FINAL PROOF SURVEY UNDER

TRANSFER NO. 4234 & 4253

Application No. .... Permit No. ....  
IN NAME OF

..... **BOB L. JONES** .....

Surveyed **MAR. 28 1984**, by **B. S. JAMES** .....