


# T. 39S., R. 8W., W.M.

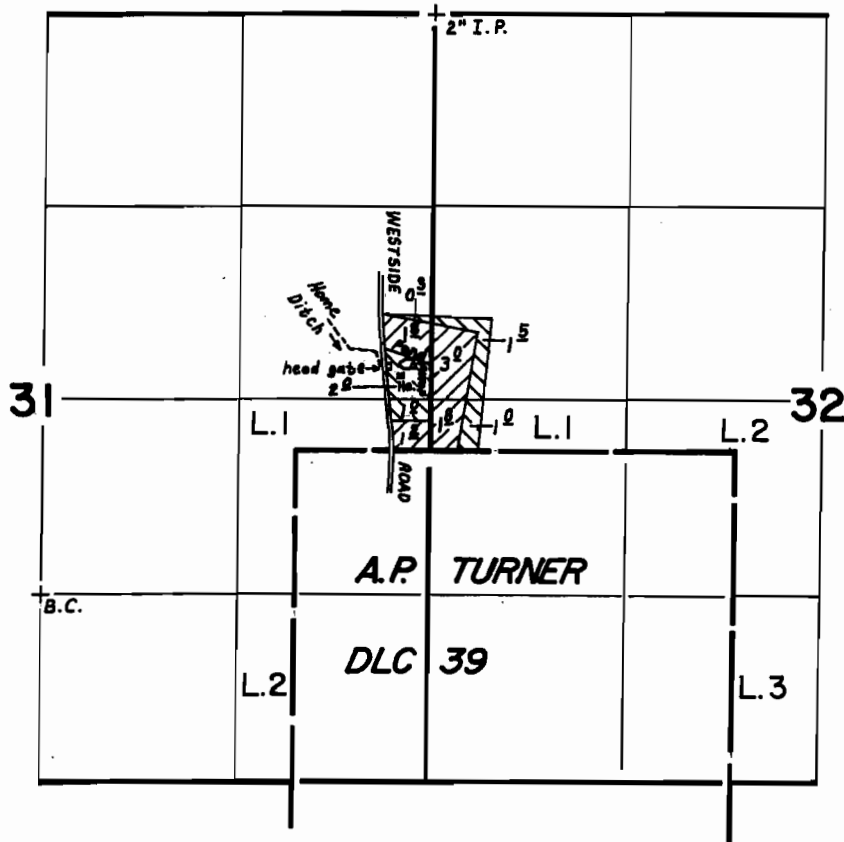

 TRANSFER NO. 4234

 TRANSFER NO. 4253



SCALE: 1" = 1320'

## FINAL PROOF SURVEY UNDER

**TRANSFER NO. 4234 & 4253**

Application No. .... Permit No. ....

IN NAME OF

..... **BOB L. JONES** .....

Surveyed **MAR. 28, 1984**, by **B. S. JAMES** .....