

RECORDED


SEP 29 1994

MAILED TO COUNTY CLERK
Salem, Oregon

T. 5N., R. 27E., W.M. UMATILLA COUNTY

SCALE 1" = 1320'

Columbia River

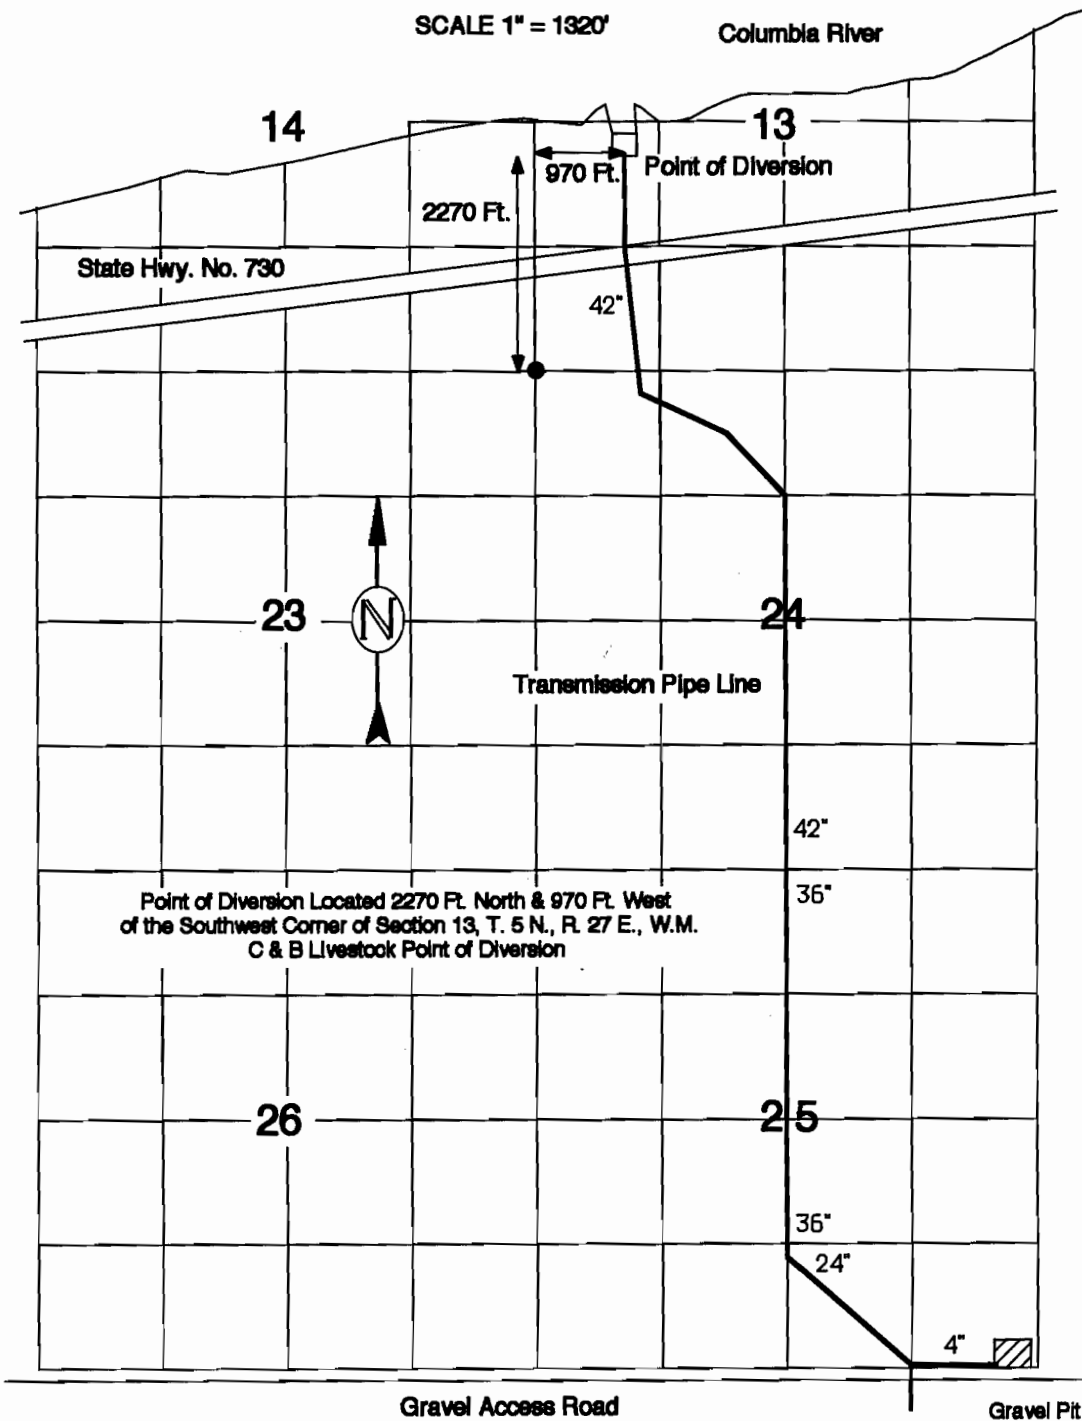

THIS MAP IS FOR THE PURPOSE
OF IDENTIFYING THE LOCATION
OF WATER RIGHTS ONLY AND IS
NOT INTENDED TO PROVIDE
LEGAL DIMENSIONS OR LOCATIONS
OF PROPERTY OWNERSHIP LINES.

WATER RIGHTS PROOF MAP
IN NAME OF
LOGSDON READY-MIX, INC.

ENGINEERING - SURVEYING - WATER RIGHTS
R V MCKINNIS ENGINEERING
 Rt 1 Box 1122 Hermiston, Oregon 97838
 503-567-2017

Professional Engineer Seal
 RONALD V. MCKINNIS
 NOV. 29, 1988
 STATE OF OREGON
 12-31-94