


T. 9 S., R. 21 E., W.M.

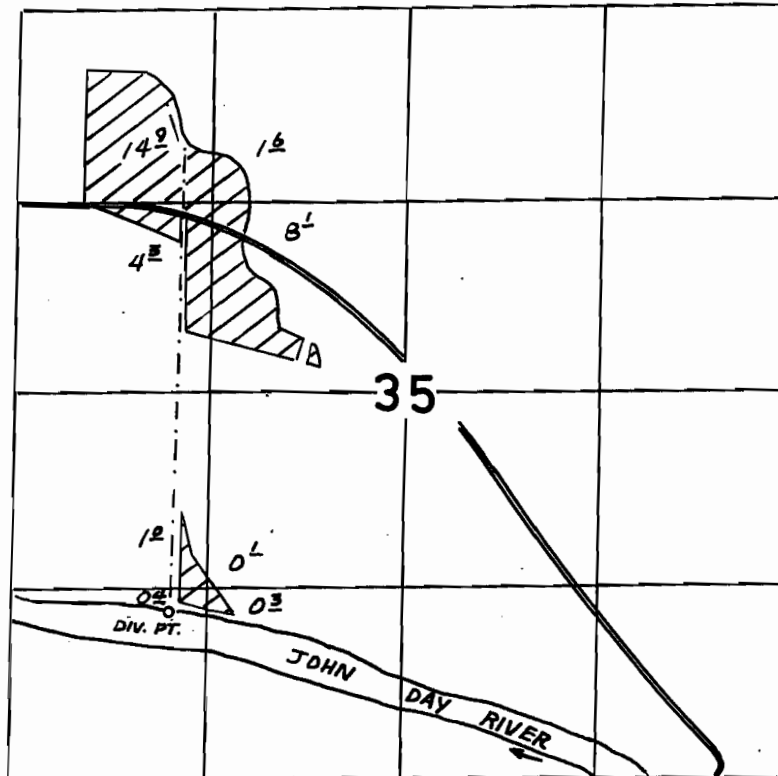

POD - 1150' N. & 1050' E. FROM THE SW COR. SEC. 35.

FINAL PROOF SURVEY
UNDER

Application No. 59183 Permit No. 44567
IN NAME OF

A. MATTHEW WILLIAMS

Surveyed 5-18, 1994, by J. MILLER