


RECEIVED

NOV 03 1994

WATER RESOURCES DEPT  
SALEM, OREGON

# T.4S., R.2W., W.M.

## MARION COUNTY

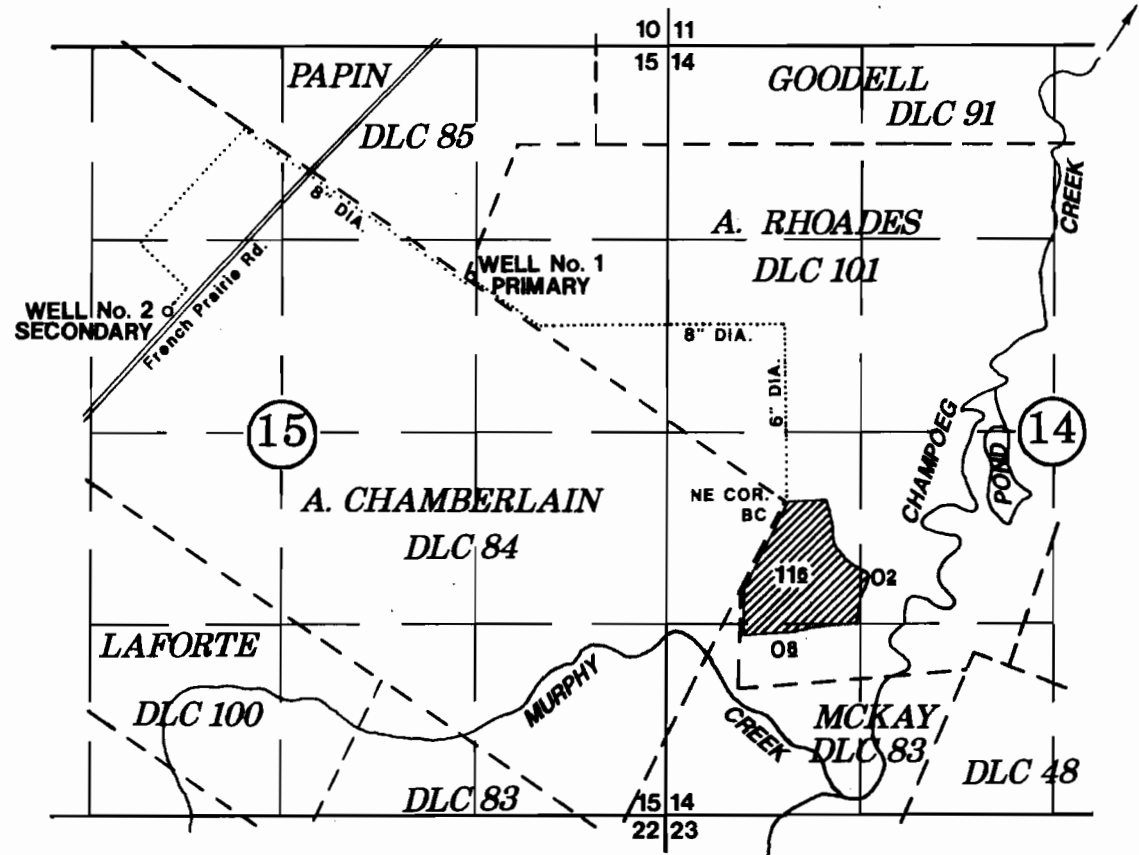

WELL LOCATION : WELL No. 1 1545' N AND 2150' W FROM THE NE CORNER OF CHAMBERLAIN DLC 84  
 same well as Proved on App. G-9971  
 ( 1500' N. & 2150' W FROM NE COR. CHAMBERLAIN DLC 84 )  
 WELL No. 2 1320' N AND 4220' W FROM THE NE CORNER OF CHAMBERLAIN DLC 84

BURIED  
 SUPPLY LINE .....

### FINAL PROOF SURVEY

Application No. G-11990 Permit No. G-11028  
 (G-11990)

**BAKER WEST INC.**

Scale 1" = 1320'

October 13, 1994



NOTE: This map is for the purpose of identifying the location of water rights and has no intent to dimension or locate property ownership lines.