


T.8 S.R.3 W.W.M.

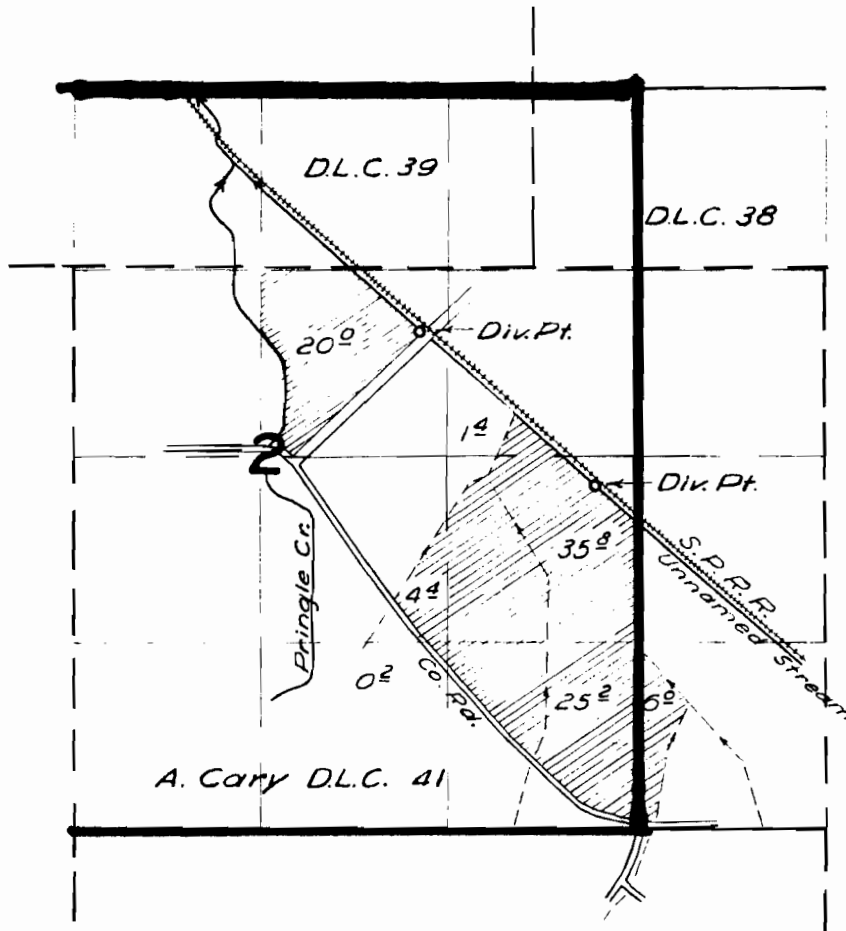

FINAL PROOF SURVEY UNDER

Application No. 24525 . Permit No. 19311
IN NAME OF

OREGON STATE BOARD OF CONTROL

Surveyed 10 June 1959, by *M. Beck*