


T.29&30S.,R.5W.,W.M.

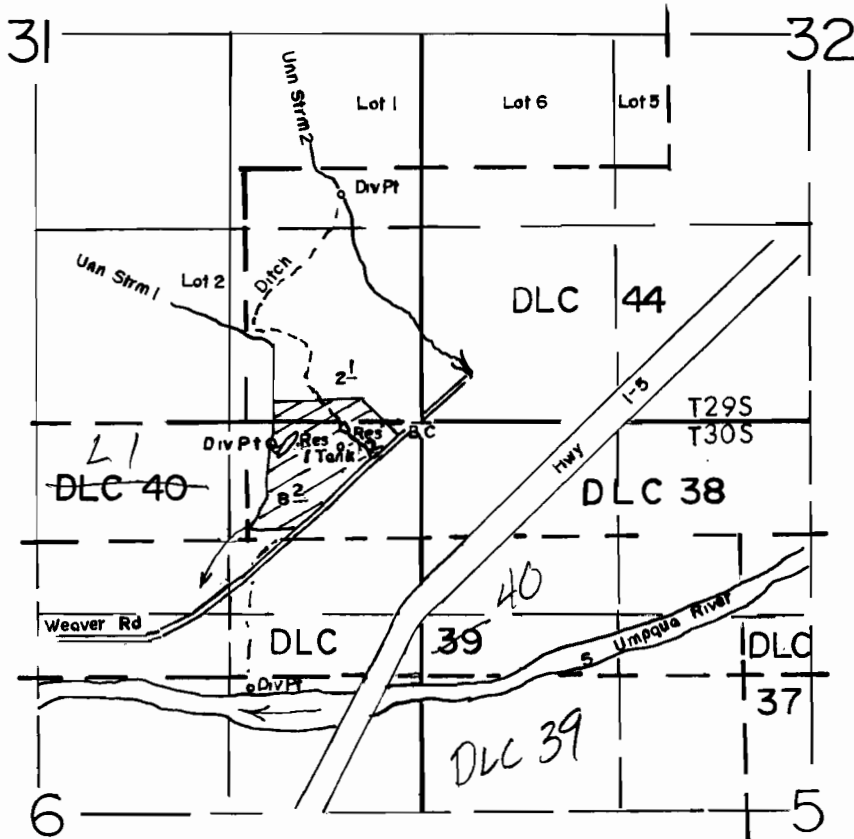

Div Pts Loc-Stream 1, 150'S & 1050'W, Stream 2, 1550'N & 550'W, River-1900'S & 1150'W All From The NE Corner Of Section 6

SCALE: 1"=1320'

FINAL PROOF SURVEY UNDER

R-62121 R-8401
Application No. 62122.. Permit No. 46680.....
IN NAME OF

.....Darrell Henry Green.....

Surveyed APRIL 24 1990., by B.S. JAMES.....