


T.29&30S,R.5W,W.M.

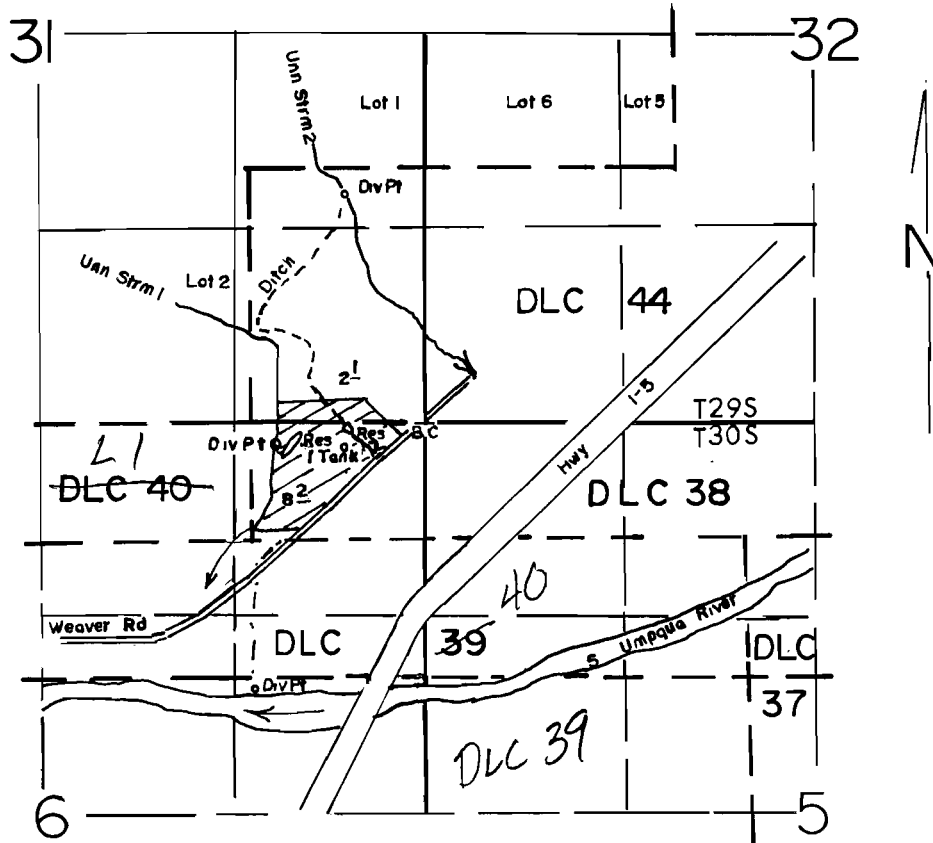

Div Pts Loc-Stream 1, 150'S & 1050'W, Stream 2, 1550'N & 550'W, River-1900'S & 1150'W All From The NE Corner Of Section 6

SCALE: 1"=1320'

**FINAL PROOF SURVEY**  
UNDER

R-62121                      R-8401  
Application No. 62122..    Permit No. 46680.....  
IN NAME OF

.....Darrell Henry Green.....

Surveyed APRIL 24 1990., by B.S.JAMES.....