

PREPARED BY:  
JONATHAN C. SPERO W.R.E. 123  
1002 KINCAID RD./P.O. BOX 16  
WILLIAMS, OREGON 97544  
PHONE (503) 846-6845

# T.37 S. R.05 W. W.M. SECTION 34

HWY 238

N 1/16 COR.

NW 1/16 COR.

THIS MAP IS FOR THE PURPOSE OF IDENTIFYING THE LOCATION OF THE WATER RIGHT ONLY AND IS NOT INTENDED TO PROVIDE LEGAL DIMENSIONS OR LOCATIONS OF PROPERTY OWNERSHIP LINES.



33 1/4 COR.

CW 1/16 COR.

34  
DRIVEWAY  
MOBILE HOME

WELL IS 530' S. & 70' W. FROM CW 1/16 COR.

PLACE OF USE

BURIED 3" PVC PIPE

17.8

**RECEIVED**

SCALE: 1" = 400'

S 1/16 COR.


34

SW 1/16 COR.

33

## FINAL PROOF SURVEY

SURVEYED JUNE 15, 1995  
BY JONATHAN C. SPERO  
C.W.R.E. # 123

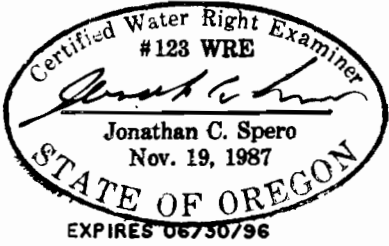

UNDER  
APPLICATION NO. **G-12124**  
PERMIT NO. **G-11208**

IN THE NAME OF **DON JACKSON**