



T.10 & 11S., R.2W., W.M.

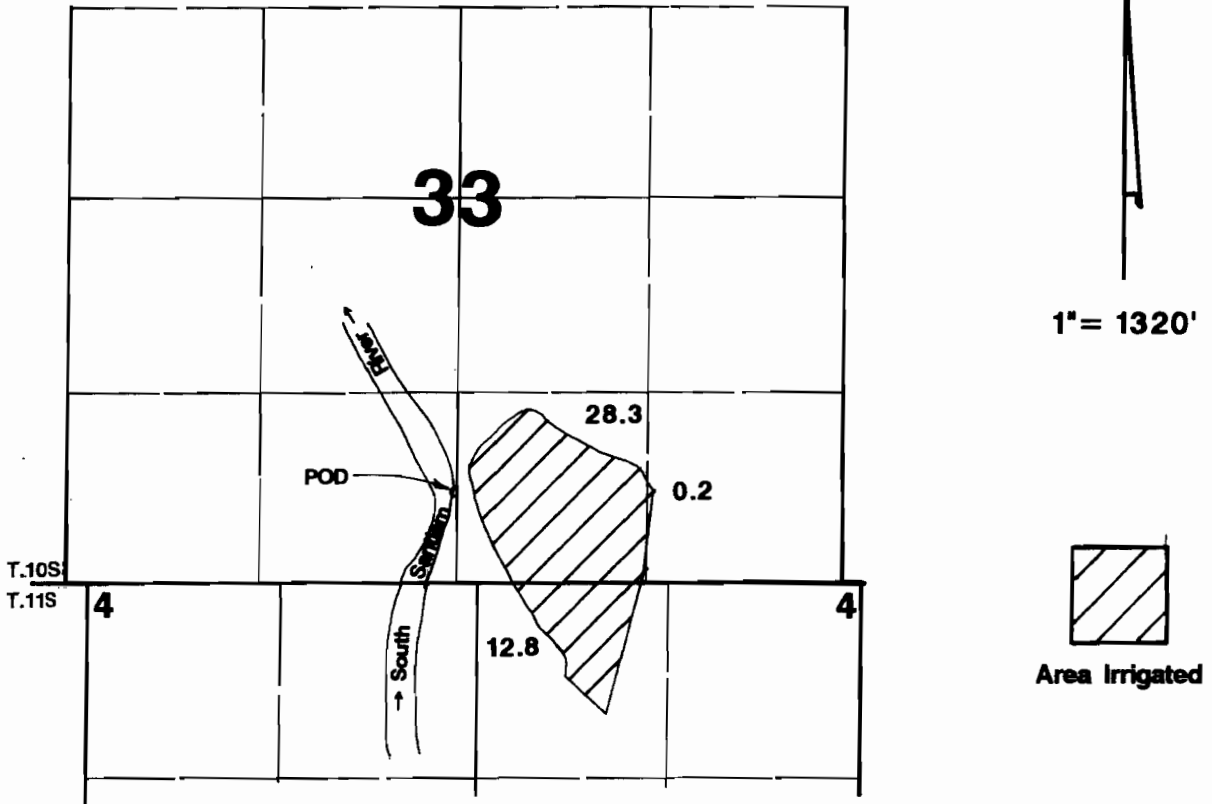

POD located 2027'S & 5'W from center of Section 33.

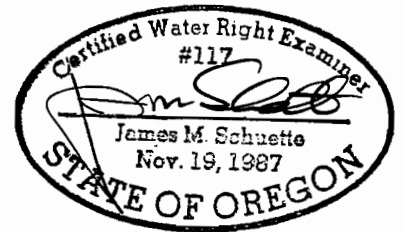

Final Proof Survey

Application #: 69736

Permit #: 50719

In Name Of

Angelika Spalt

Surveyed on September 3, 1993 by JM Schuette

RECEIVED

OCT 01 1993

WATER RESOURCES DEPT.
SALEM, OREGON

THIS MAP WAS PREPARED FOR THE PURPOSE OF IDENTIFYING THE LOCATION OF A WATER RIGHT ONLY AND IS NOT INTENDED TO PROVIDE LEGAL DIMENSIONS OR LOCATION OF PROPERTY OWNERSHIP LINES.