


T. 13 S., R. 31 E., W.M.

RECEIVED

JUL - 1 1993

WATER RESOURCES DEPT.
SALEM, OREGON

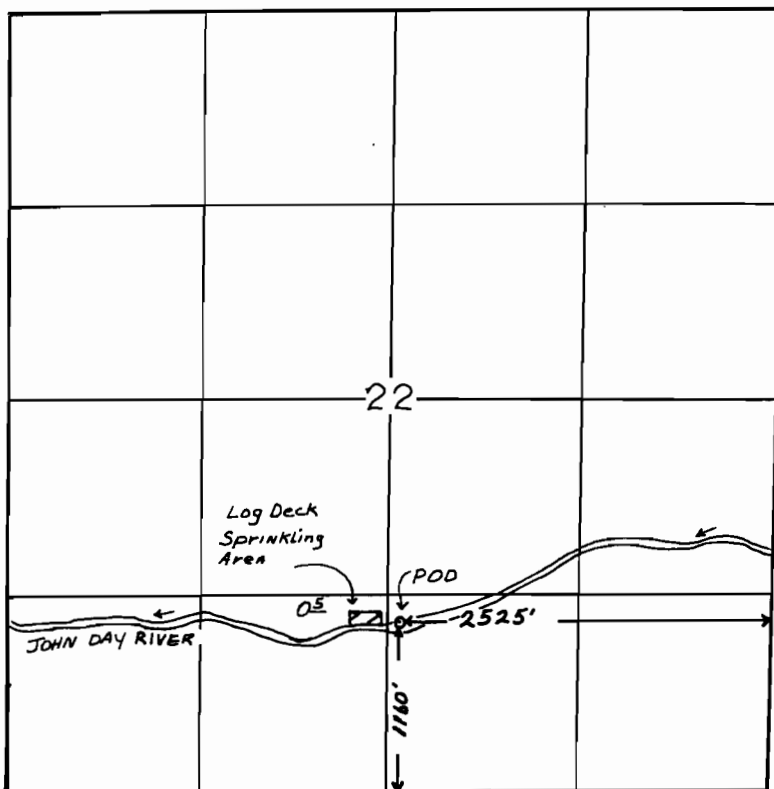

FINAL PROOF SURVEY

UNDER

Application No. 68942 Permit No. 49897
IN NAME OF

OREGON PINE

Surveyed 9-4, 1990, by K. KEMP

↑
N
1" = 1320'