


T.5S.R.3W.W.M.

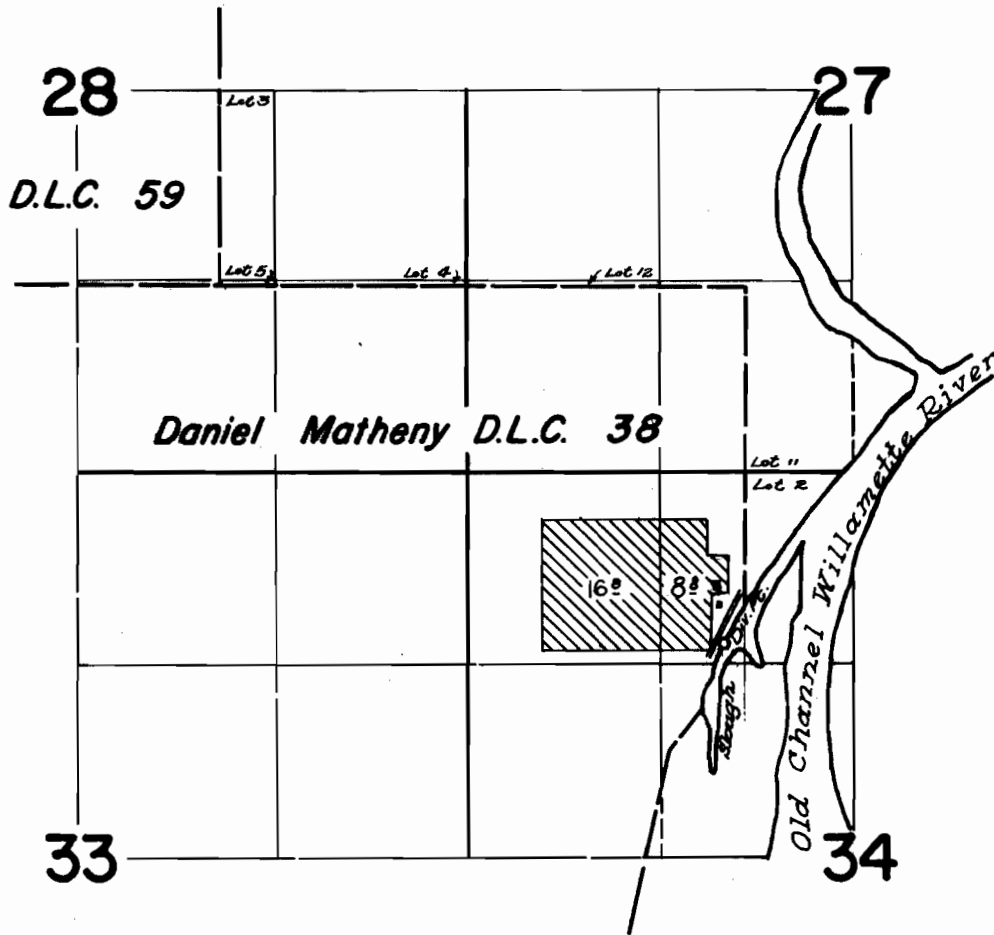

FINAL PROOF SURVEY
UNDER

Application No. 37044 Permit No. 27567.....
IN NAME OF

EVELYN L. TERRY

Surveyed August 30 1982, by [Signature]