


IRRIGATION SYSTEM KEY

- DIVISION BOXES
- WELL
- 1/16 QUARTER CORNER - NOT FOUND
- ◇ SECTION CORNER - FOUND
- DIRT DITCH
- - - 8" PIPE AND GATED PIPE
- ..... 8" SUPPLY FROM WELLS
- · - · - 4" BURIED SPRINKLER MAINLINE
- 18" CONCRETE DITCH

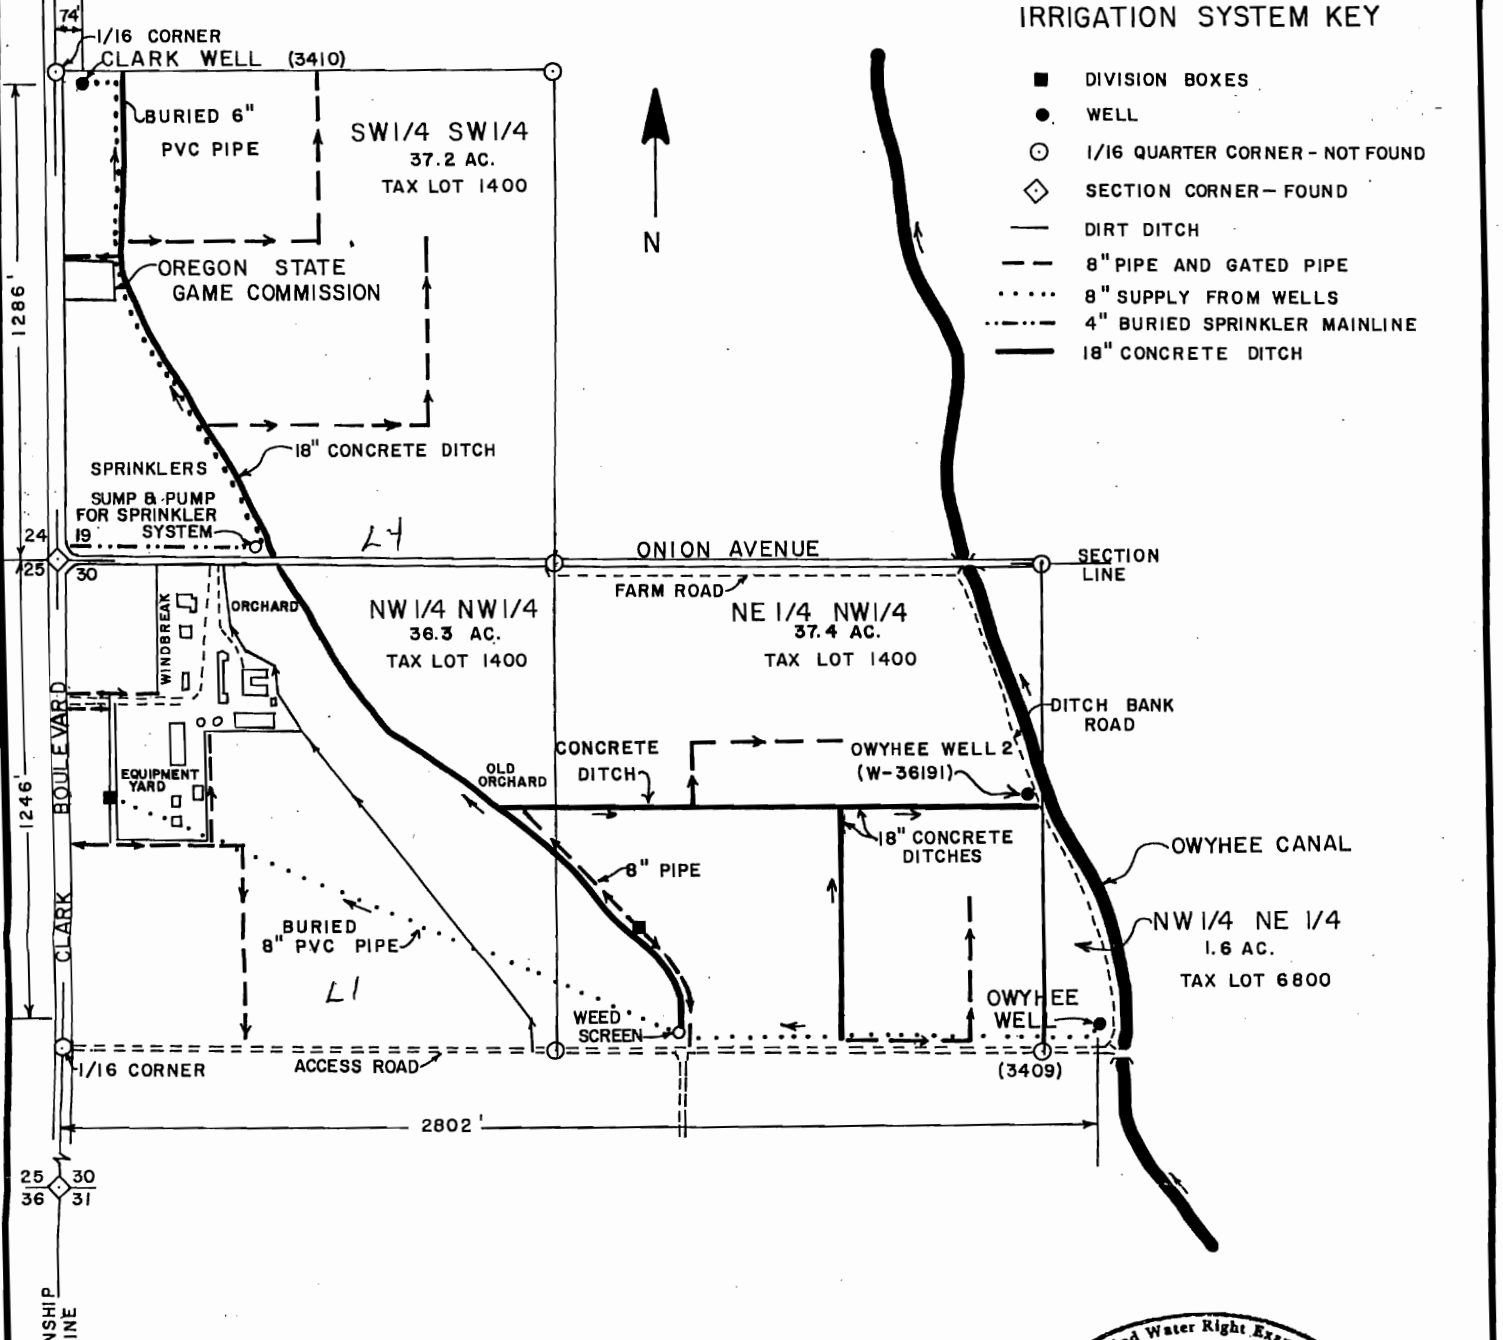

NOTES

1. THIS MAP IS FOR THE PURPOSE OF LOCATING A WATER RIGHT AND IS NOT INTENDED TO PROVIDE LEGAL DIMENSIONS FOR LOCATIONS OF PROPERTY OWNERSHIP BOUNDARIES.
2. LOCATION: T 18 S, R 47 E W.M.
3. OWYHEE WELL - START CARD NO. 3409  
CLARK WELL - START CARD NO. 3410
4. ONION AVENUE WAS PREVIOUSLY NAMED OWYHEE AVENUE.
5. ENTIRE AREA IRRIGATED EXCEPT ROADS AND EQUIPMENT YARD.



VERN PRITCHARD		473-3612
P.O. BOX 134		
VALE, OREGON		97918
MALHEUR EXPERIMENT STATION		
FINAL PROOF SURVEY		
DRAWN <i>Diane Pritchard</i>	SCALE 1" = 400'	
APPROVED <i>Vernon R. Pritchard</i>	DWG NO. 010	
DATE SEPT 25, 1994	SHEET 1 OF 1	

Gov't AGTS ENTERED BY WRD STAFF, 4-28-09 JWS