


SECTION 29, T. 1 S., R. 2 W., W.M.  
WASHINGTON COUNTY OREGON

RECEIVED

MAR 15 1995

WATER RESOURCES DEPT.  
SALEM, OREGON

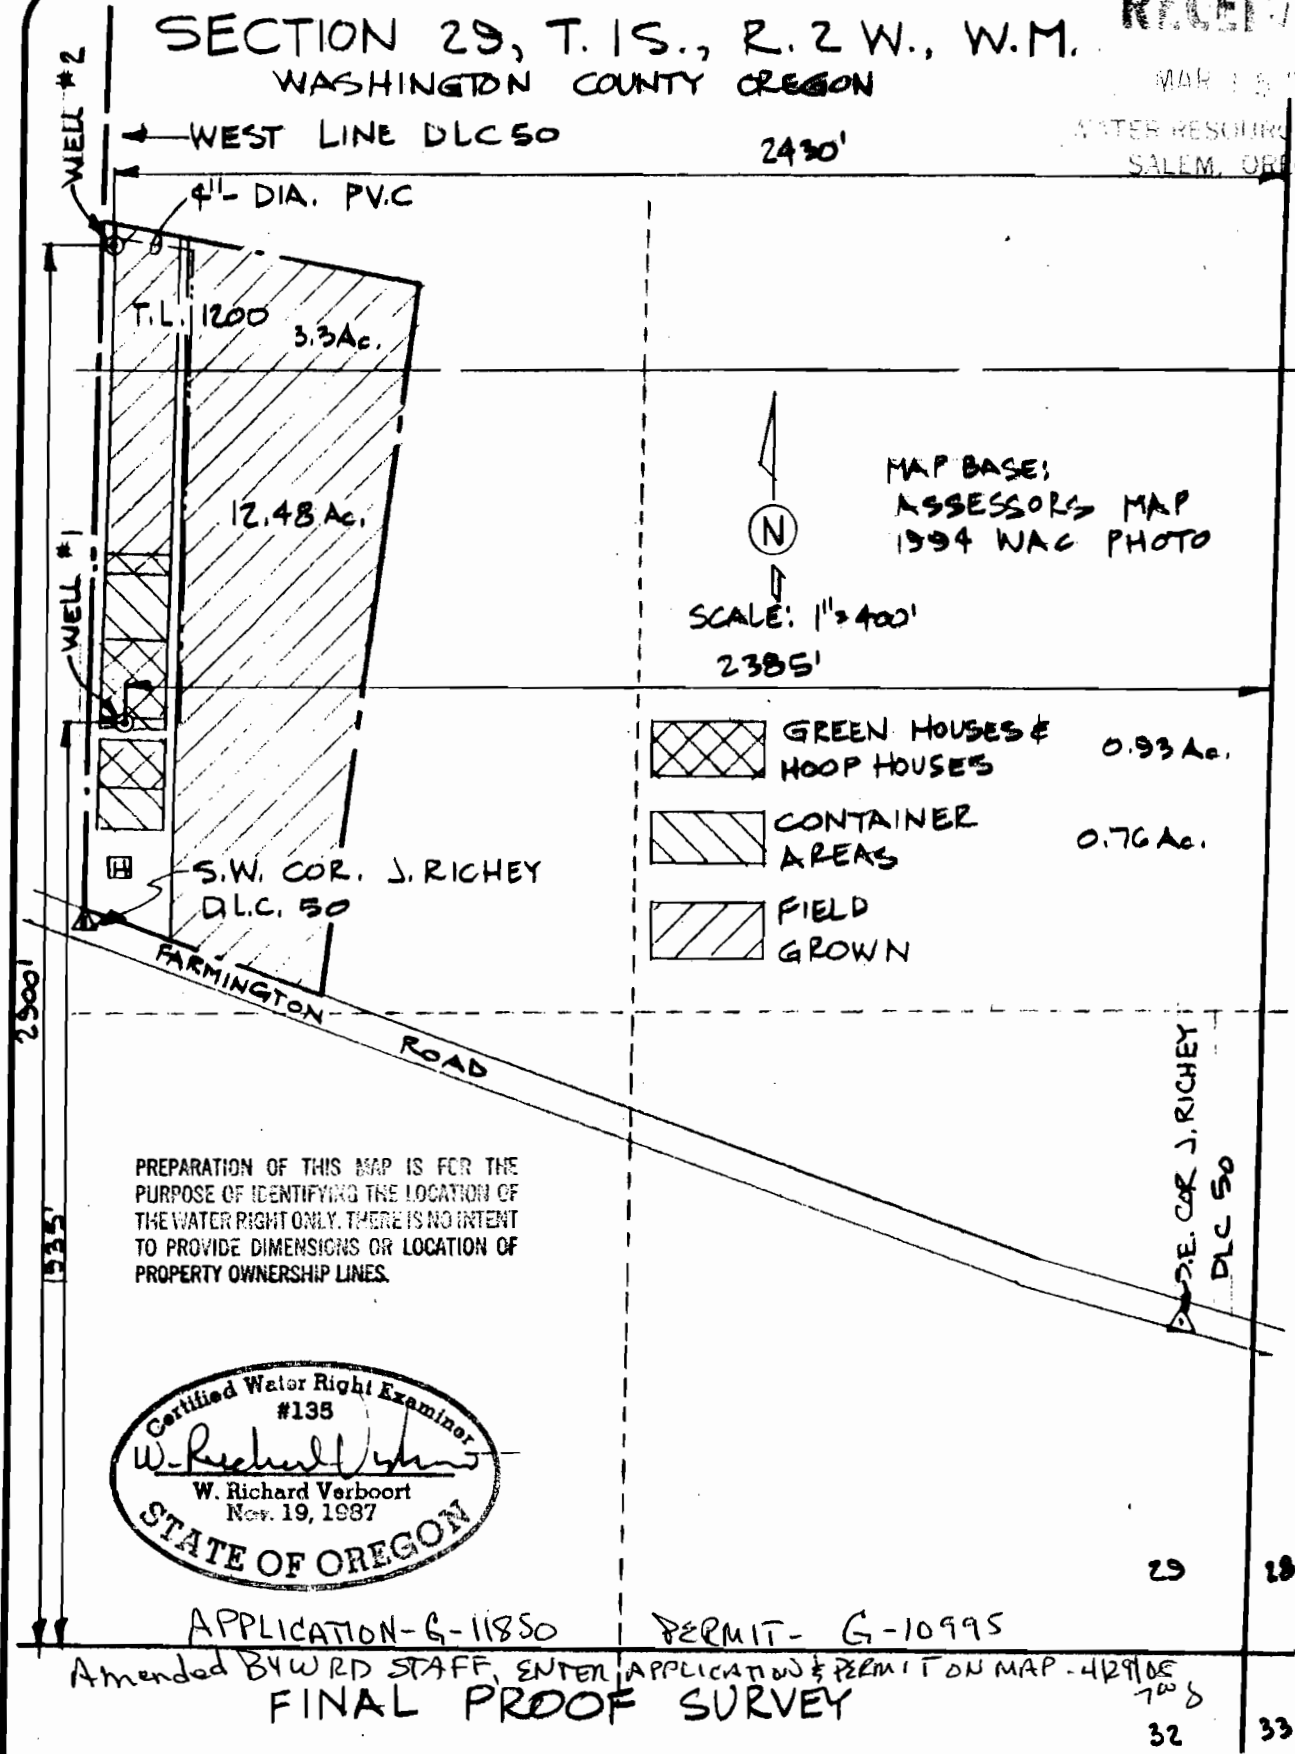

Certified Water Right Examiner  
#135  
*W. Richard Verboort*  
W. Richard Verboort  
Nov. 19, 1987  
STATE OF OREGON

APPLICATION - G-11850 PERMIT - G-10995  
Amended BY WRD STAFF, ENTER APPLICATION & PERMIT ON MAP - 4/29/05  
FINAL PROOF SURVEY

SURVEYED 3-7-95

VERBOORT ENGINEERING  
AGRICULTURE - CIVIL - WATER RESOURCES  
HILLSBORO, OREGON

designed by date  
WRV 3-95  
drawn JER 3-95  
checked WRV 3-95  
drawing no. 95-A-03  
sheet no. 1/1

OREGON ORNAMENTALS  
27875 S.W. FARMINGTON ROAD  
HILLSBORO, OR 97123