


T. 39 S., R. 2 E., W. M.

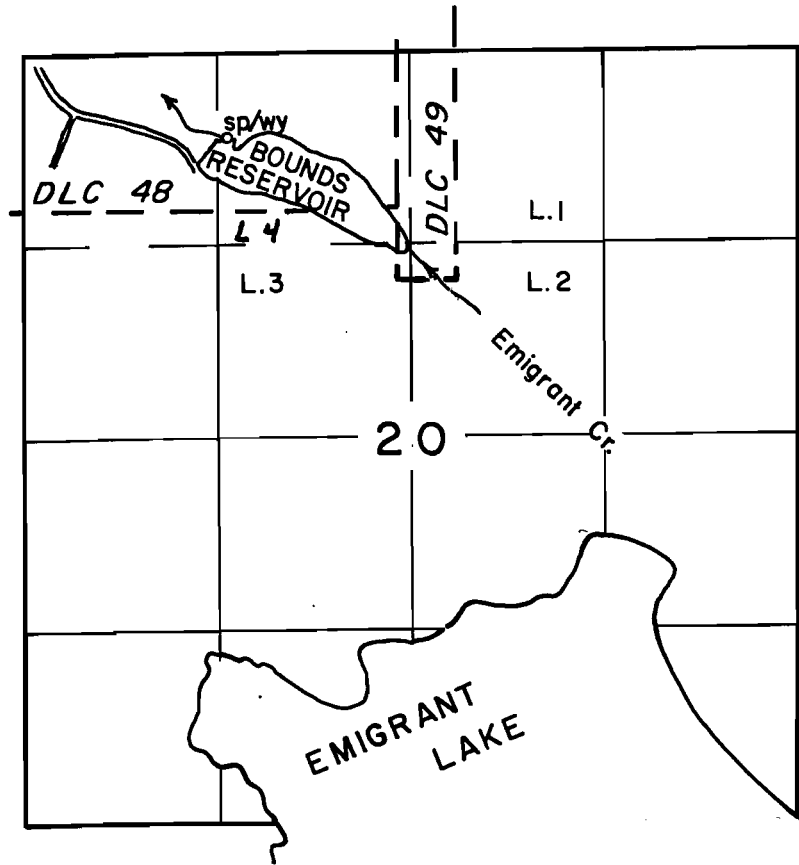

Scale: 1" = 1320'

FINAL PROOF SURVEY
UNDER

Application No. R-34856 Permit No. R-8541
IN NAME OF

.....RENE L. BOUNDS.....

Surveyed JULY 23 1991., by ..B.S. JAMES..