


T. 8S., R. 19E., W. M.

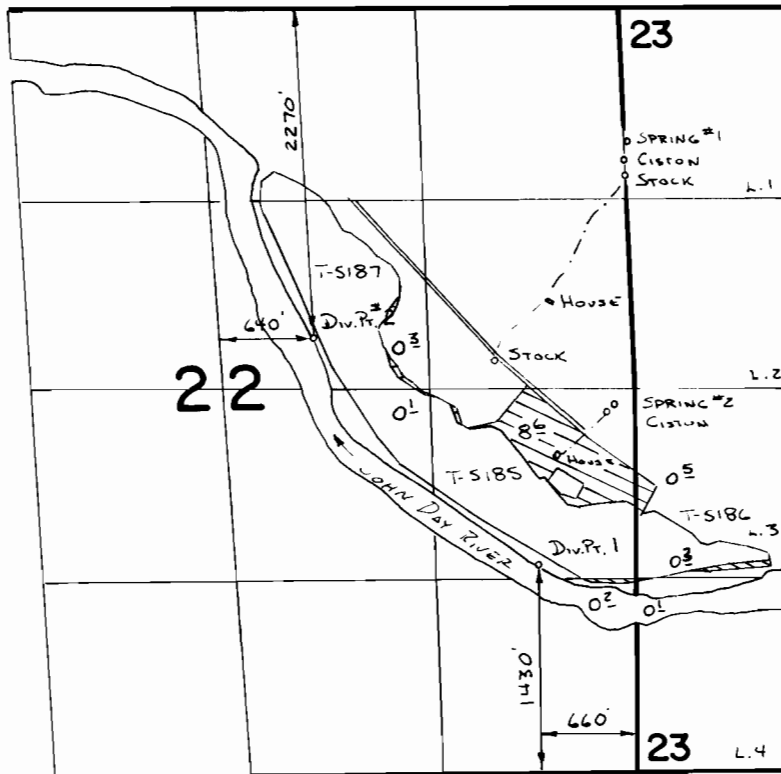

SCALE 1" = 1320'

SPRING #1 Loc: 920'S. & 20'E. FROM NW. COR. SEC. 23
 SPRING #2 Loc: 100'S. & 140'W. FROM E 1/4 COR SEC 22

FINAL PROOF SURVEY
 UNDER

TRANSFERS 5185, 5186, 5187
 Application No. **64524**. Permit No. **47231**....
 IN NAME OF

.....**JON BOWERMAN**.....

Surveyed 5-12..... 1987, by V.L. Church.....