


T.I.S. R.20E., W.M.

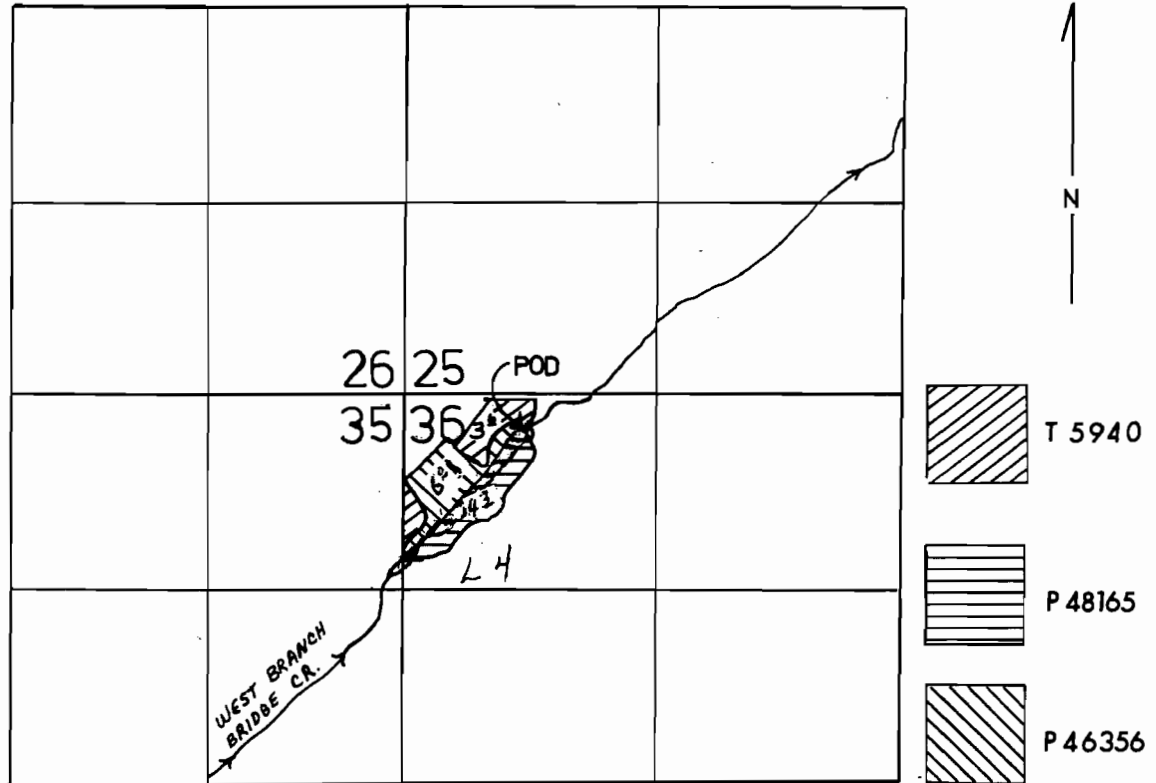

POD - NW 1/4 NW 1/4, Section 36, 460' S. & 840' E.
from the NW Corner, Section 36.

1" = 1320'

FINAL PROOF SURVEY UNDER

62137 46356
67417 48165
Application No. T.5940.. Permit No.
IN NAME OF

...VERNON T. & ROLYNNE A. MOE.....

Surveyed 11-12... 1990., by K. KEMP.....