


T.26S. R.4W.W.M.

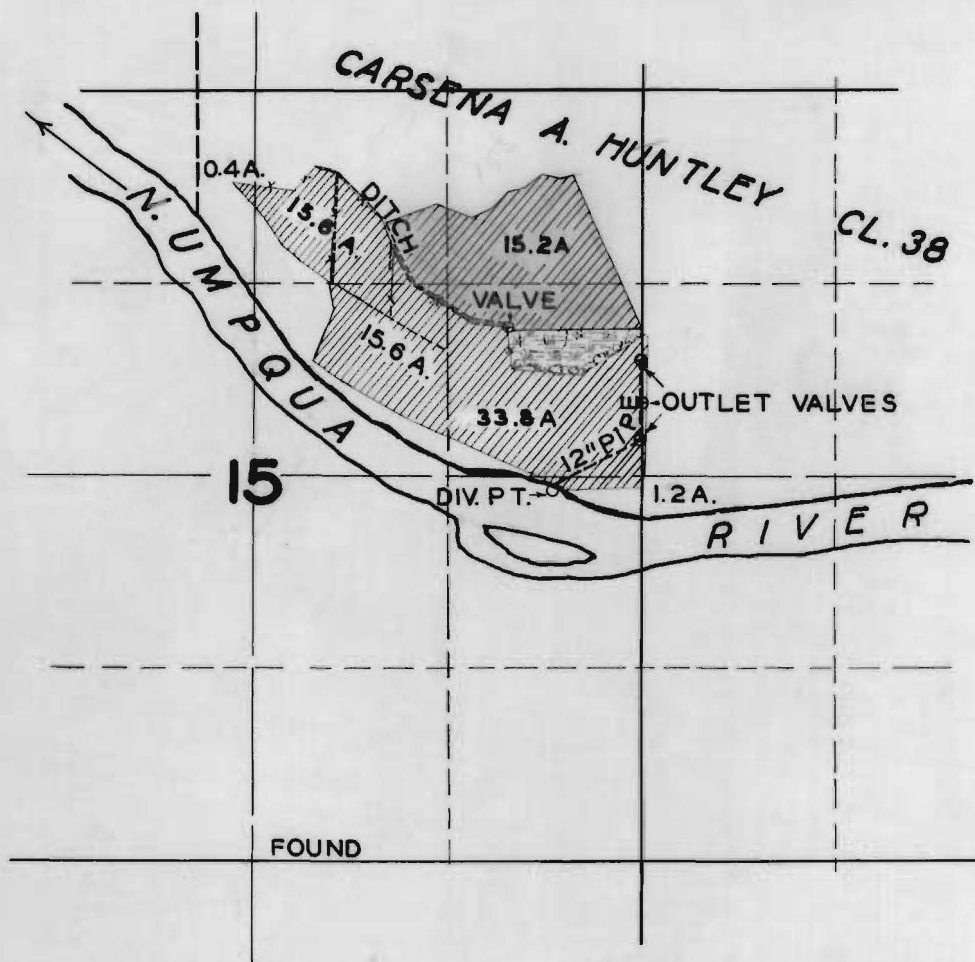

FINAL PROOF SURVEY UNDER

Application No. **16550** Permit No. **12340**
IN NAME OF

R. B. OLIVER

Surveyed **JULY 13 1949**, by **H. L. COFFMAN**

*Note: Area shaded in red
crayon was surveyed
May 5, 1953 subsequent
to issuance of
Certificate 19656*