
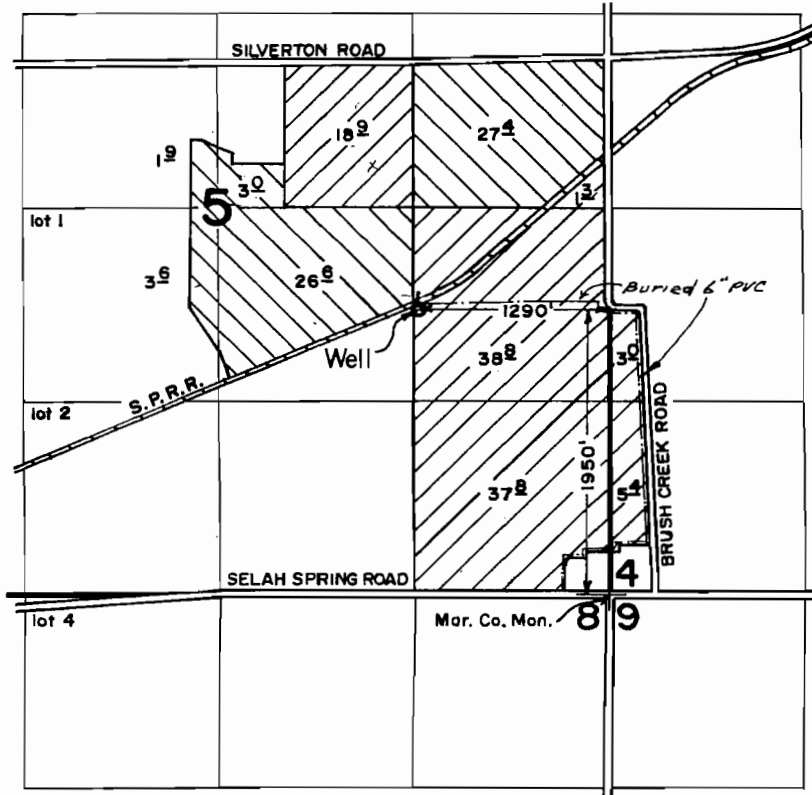



# Township 7 South, Range 1 West, W.M.


Portions of Sections 4, 5, 8 & 9


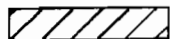

-  Primary
-  Supplemental

FINAL PROOF SURVEY  
under  
Appl. No. G-12364, Per. No. G-11258  
in name of  
BLUE LINE FARMS, INC.  
August 14, 1995

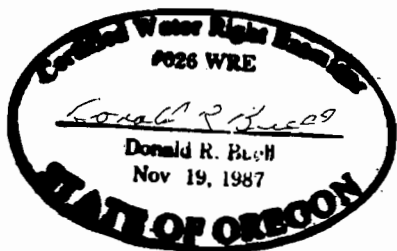

THIS MAP WAS PREPARED FOR THE PURPOSE OF IDENTIFYING THE LOCATION OF A WATER RIGHT ONLY AND IS NOT INTENDED TO PROVIDE LEGAL DIMENSIONS OR LOCATION OF PROPERTY OWNERSHIP LINES.