


T. 26 S., R. 6 W., W.M.

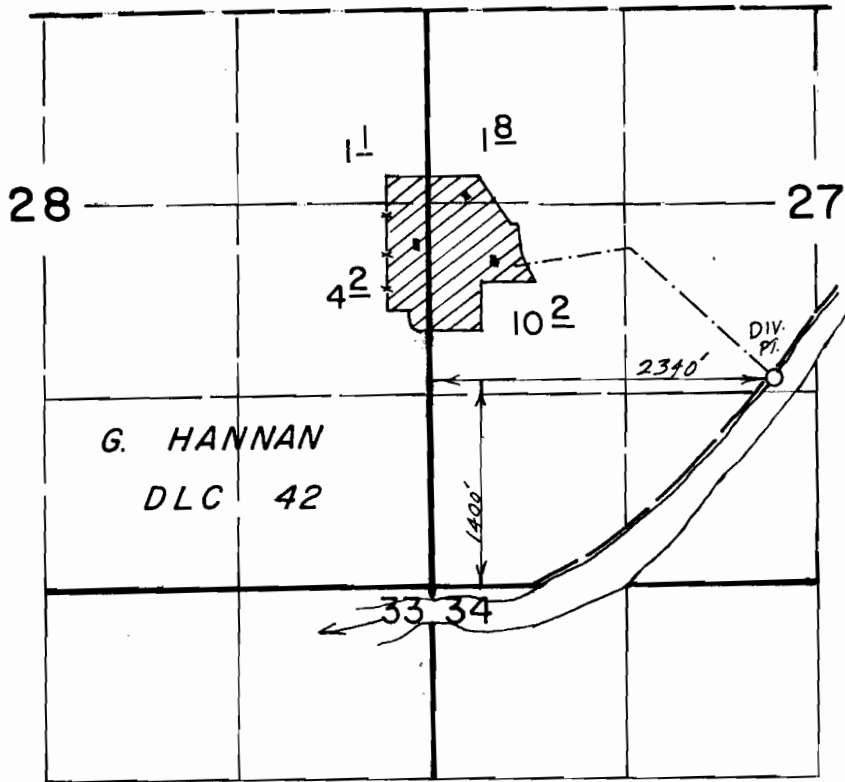

G. HANNAN
DLC 42

Scale 1" = 1320'

FINAL PROOF SURVEY
UNDER

Application No. 60362 Permit No. 45157.....
IN NAME OF

VEZZETTI, PAULSON, SWANSON.

Surveyed March 20, 1996., by S. DEHAAS.....

RECEIVED

APR 03 1996
WATER RESOURCES DEPT
SALEM, OREGON