


25312
26881

T.40S. R.19 E.W.M.

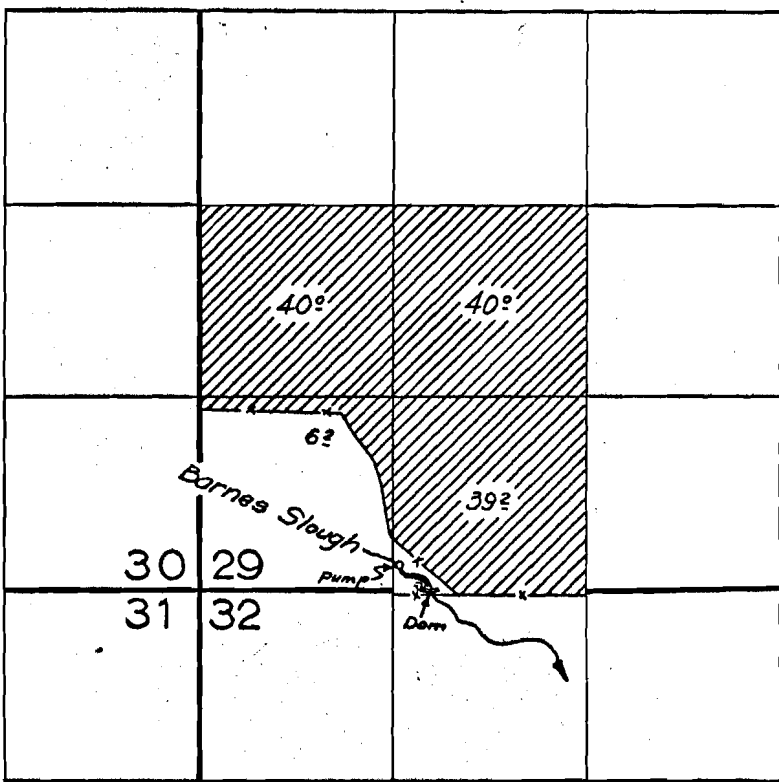

FINAL PROOF SURVEY UNDER

Application No. 31.98.2... Permit No. 25312...
IN NAME OF

C. V. FENIMORE

Surveyed May 7, 1959, by R. Jackson

40-19 ✓

CHZ-56K-185