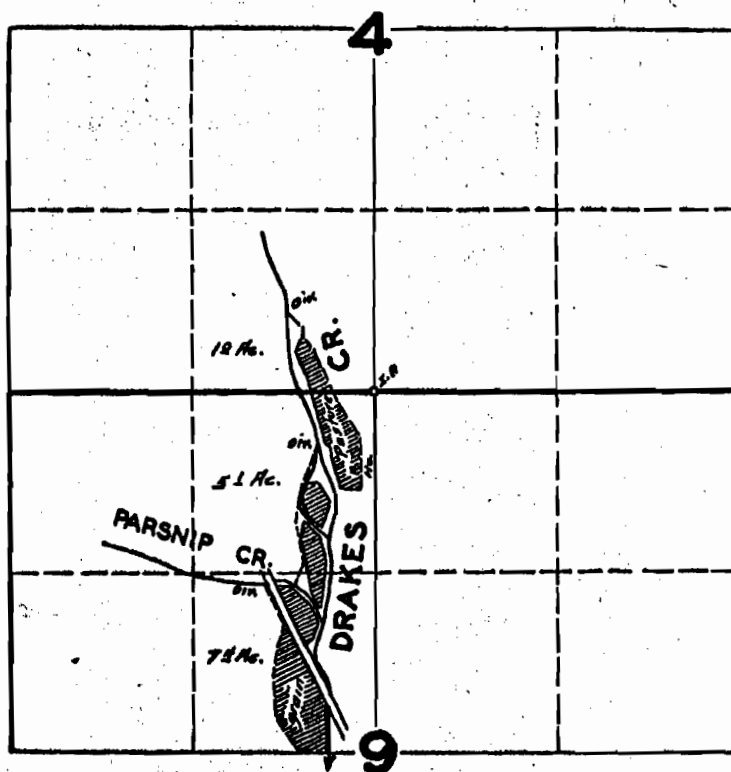


13458

20324

T.39S.R.23E.W.M.

**FINAL PROOF SURVEY**
UNDER

Application No. 17771 Permit No. 13458

IN NAME OF

WILLIAM O. MARVINDALE

Surveyed MAY 24 1946, by *W. B. Sumrell*

T 10876

39-23 ✓

1948-C

MAP TO ACCOMPANY TRANSFER APPLICATION LEON FLICK

PERMIT 13458, CERTIFICATE 20324

CHANGE IN POINT OF DIVERSION

SE $\frac{1}{4}$ SW $\frac{1}{4}$ SEC. 4 & E $\frac{1}{2}$ NW $\frac{1}{4}$ SEC. 9


T.39S. R.23E.W.M.

LAKE COUNTY, OREGON



SCALE 1"=1320'

POD Will Move From
300' S x 1020' W of
NE cor. SE $\frac{1}{4}$ NW $\frac{1}{4}$
Sec. 9
To 110' South x 745'
West of NE cor.
SE $\frac{1}{4}$ NW $\frac{1}{4}$ Sec. 9
Creek & Hwy Are
Being Relocated.

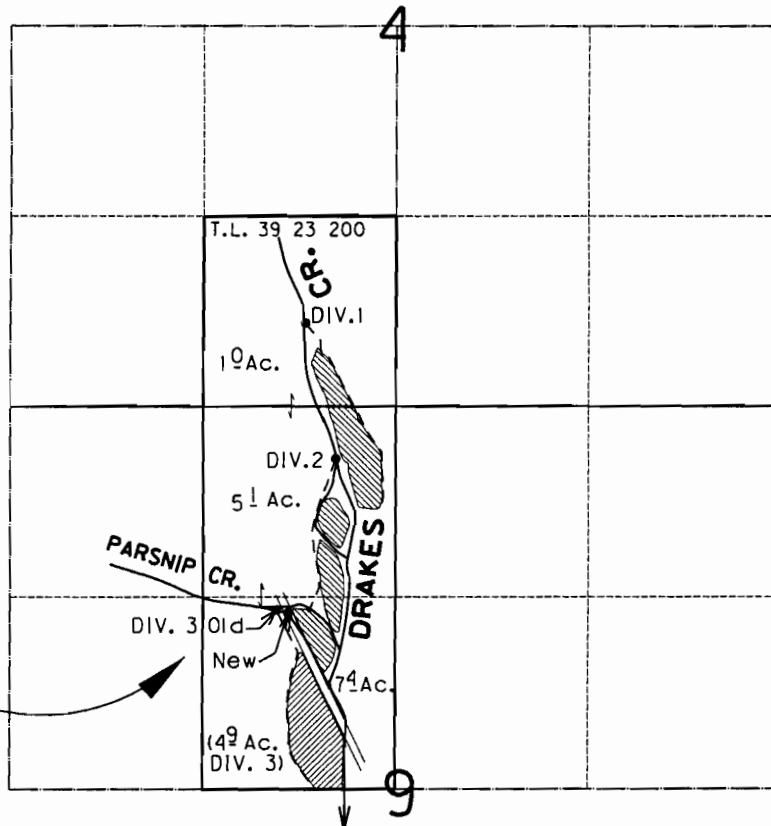

RECEIVED

MAR 13 2009

WATER RESOURCES DEPT
SALEM, OREGON


NOTE: THIS DRAWING IS A TRACING
OF THE ORIGINAL FINAL PROOF
SURVEY TO ILLUSTRATE THE CHANGE
IN POINT OF DIVERSION 3.
THIS IS NOT A LAND SURVEY.
PROPERTY BOUNDARIES, WATER USE
AND IRRIGATED ACREAGE WERE NOT
SURVEYED.



FLOOD IRRIGATED FROM DRAKE
CREEK (POD 1 & 2) NOT A PART
OF THIS APPLICATION



FLOOD IRRIGATED FROM PARSNIP
CREEK (POD 3)
ONLY POD BEING TRANSFERRED

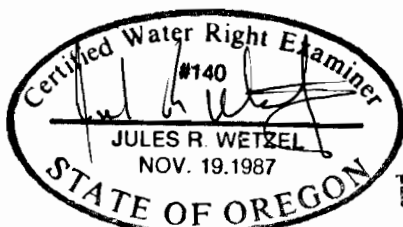

PREPARED BY:

OREGON DEPT. OF TRANSP.
REGION 4 TECHNICAL CENTER
63085 N. HWY 97, STE. 102
BEND, OREGON 97701