


T. 5 S., R. 4 W., W.M.

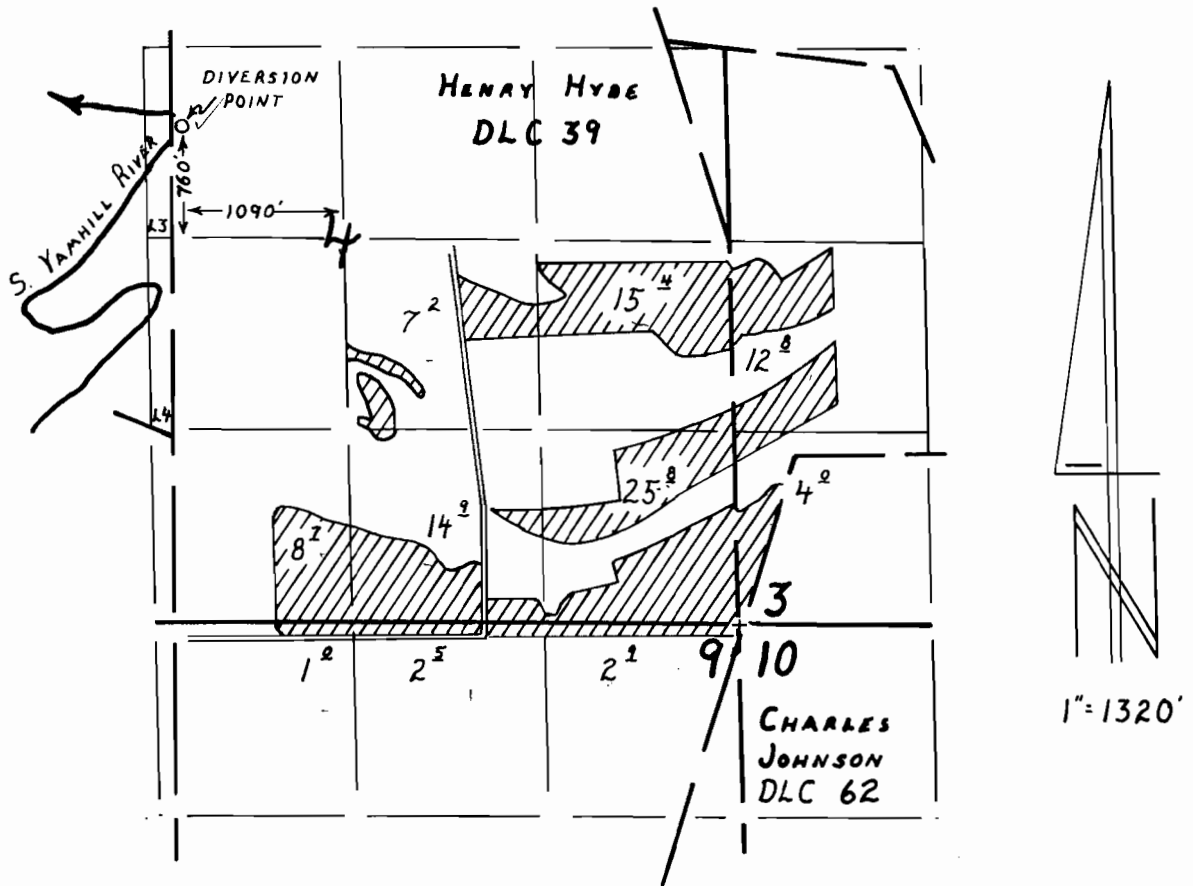

FINAL PROOF SURVEY

UNDER

Application No. 61226 Permit No. 46335
IN NAME OF

BANSEN JERSEYS, INC.

Surveyed JUNE 15, 1993, by R.W. Klassen