


RECEIVED

T.1S., R.3E., W.M.
SECTION 24

AUG - 1 1997

WATER RESOURCES DEPT
SALEM, OREGON

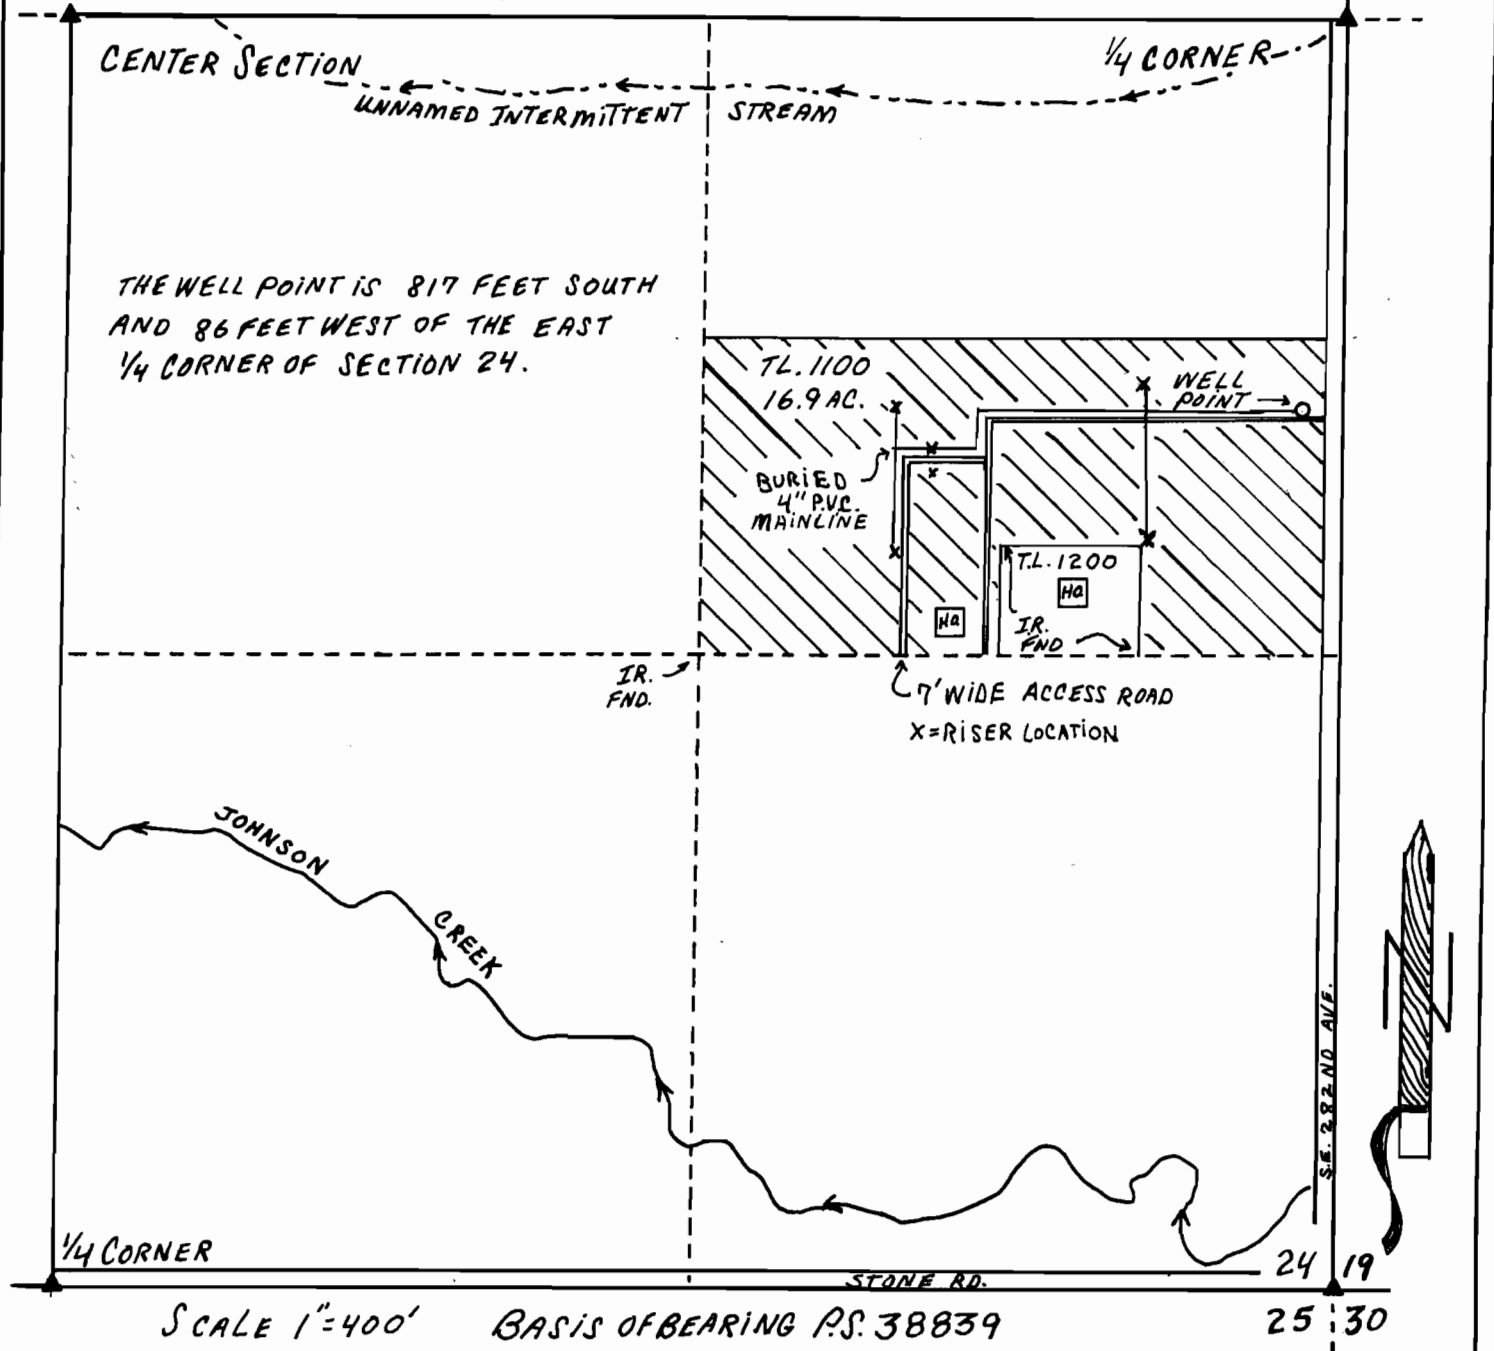


FINAL PROOF SURVEY

UNDER

APPLICATION # G-13089 PERMIT # G-12270

IN THE NAME OF

EKSTROM NURSERY

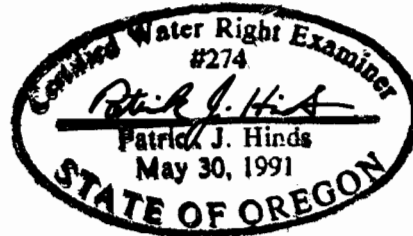

SURVEYED JULY 24, 1997