



THIS MAP WAS PREPARED FOR THE PURPOSE OF IDENTIFYING THE LOCATION OF THE WATER RIGHT AND IS NOT INTENDED TO PROVIDE LEGAL DIMENSIONS OR LOCATIONS OF PROPERTY OWNERSHIP LINES.

T20S; R10E

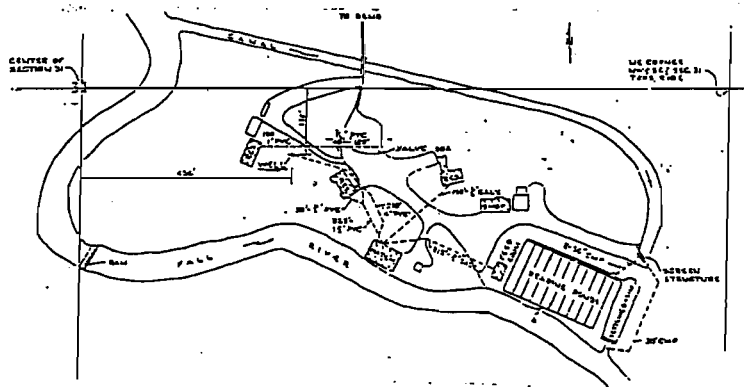

SCALE: 1" = 400'

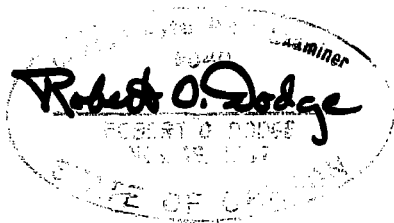

**FINAL PROOF SURVEY**  
UNDER  
APPLICATION NO. G-13927 PERMIT NO. G-12749  
IN NAME OF  
**OREGON DEPARTMENT OF FISH AND WILDLIFE**  
SURVEYED: 7/17/97 BY: DODGE