


**Claim Of Beneficial Use
Sunshine Village Water Association
Application G-11752, Permit G-11199
T 38 S, R 3 W, Section 27 & 34, W.M.**

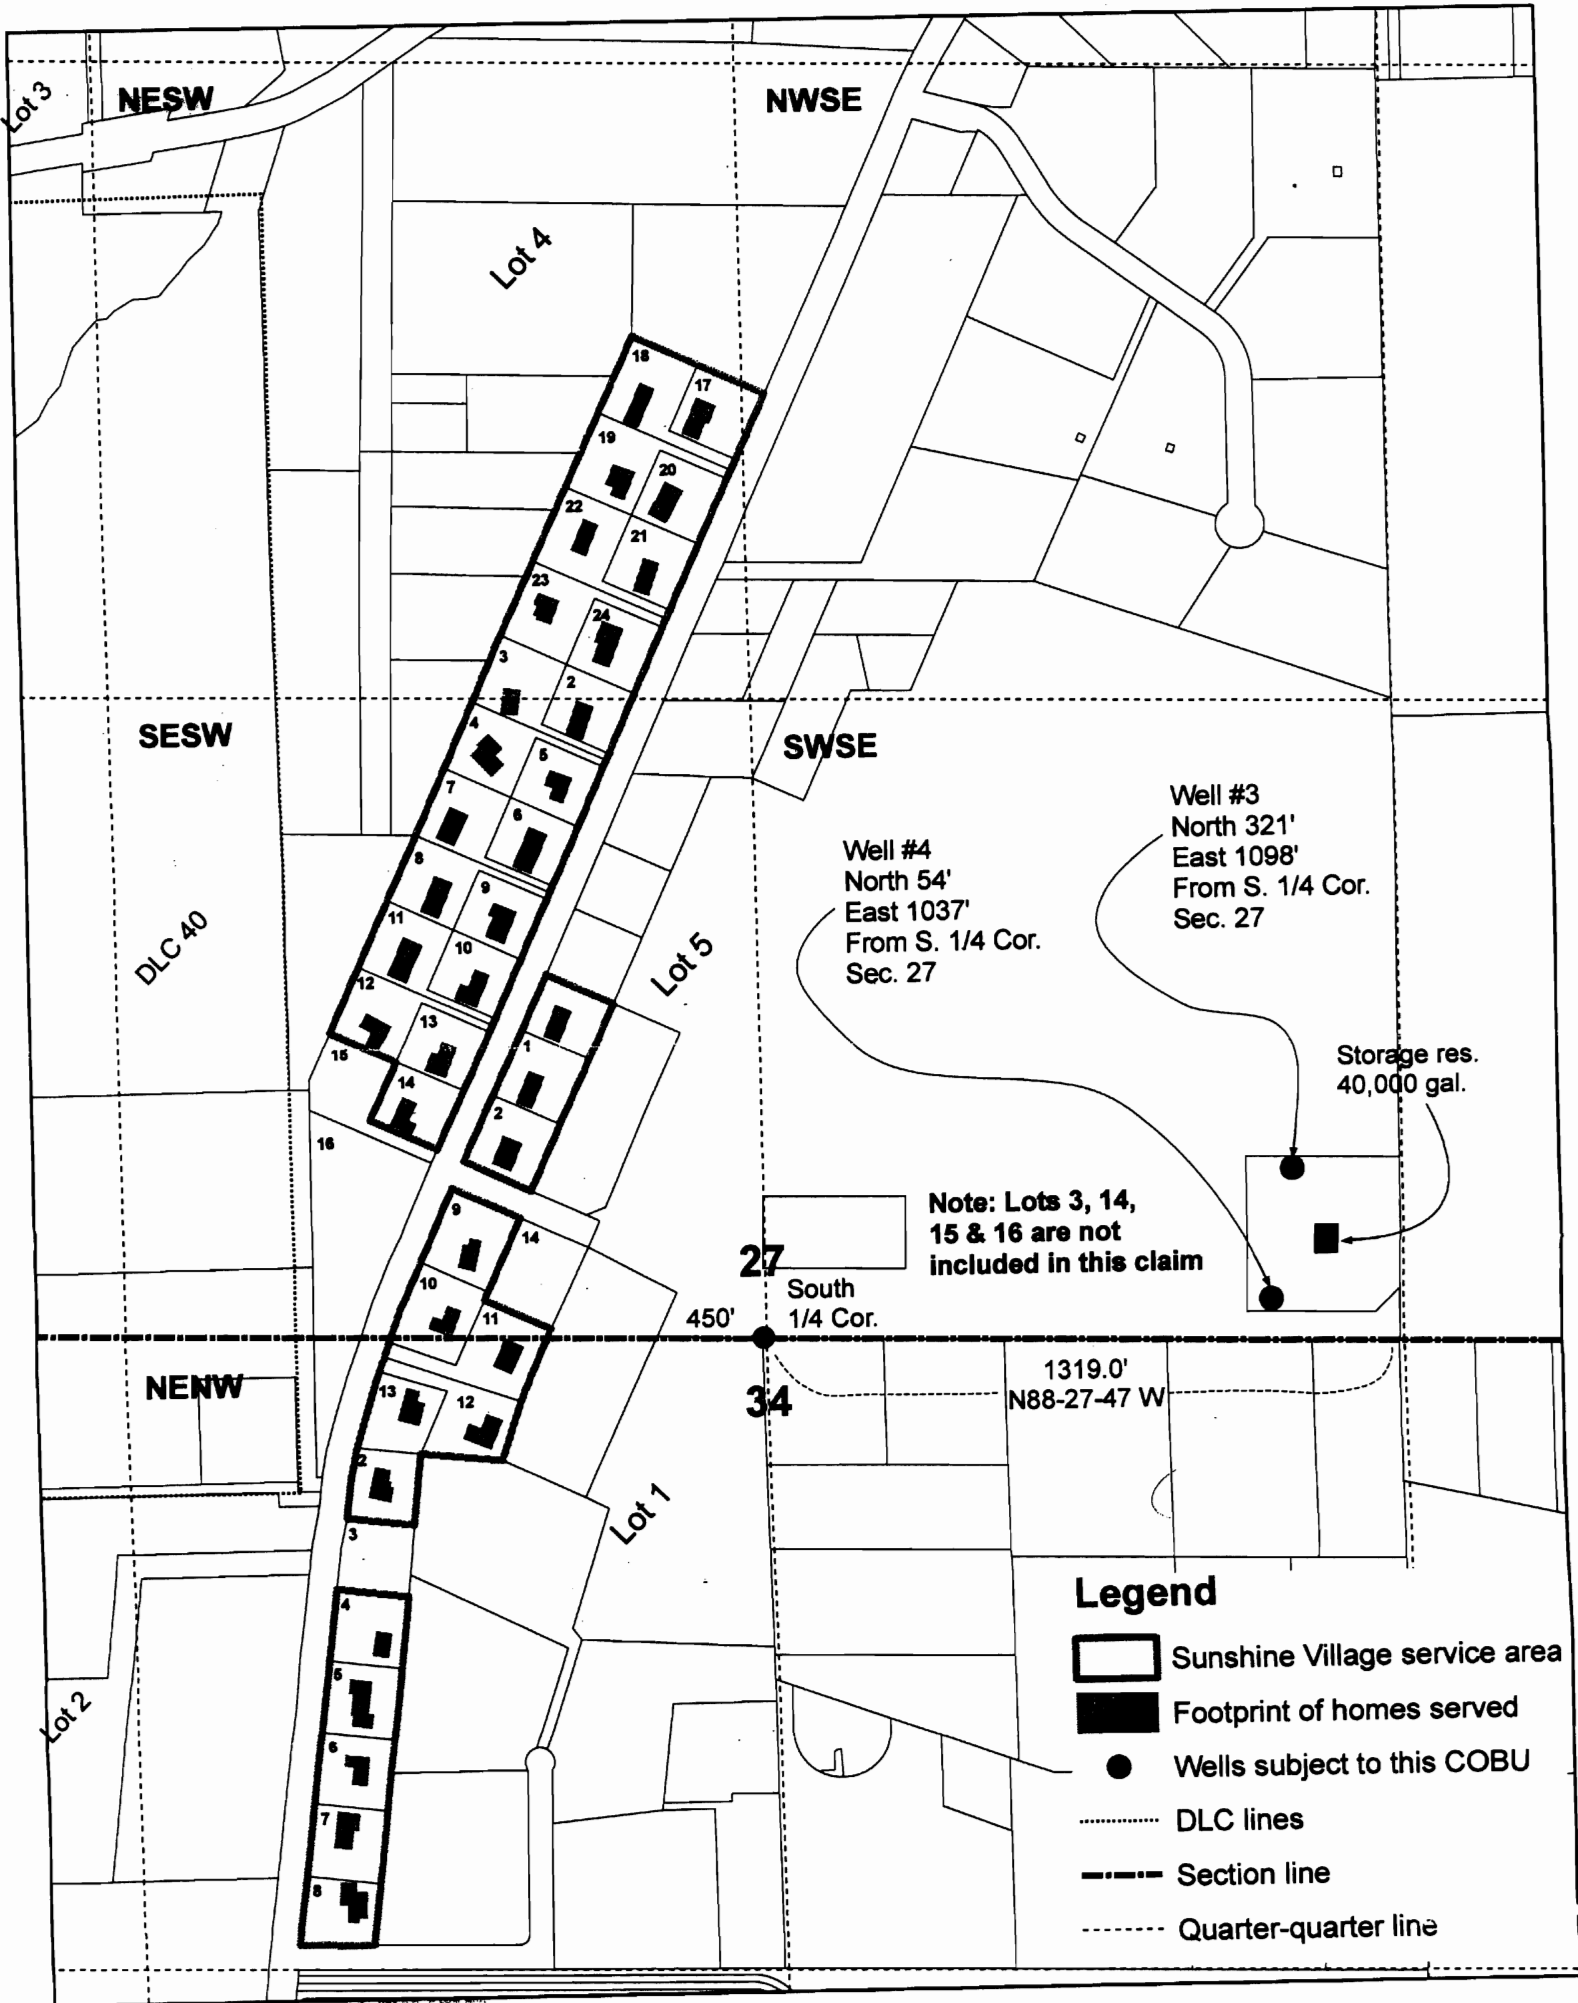

RECEIVED



DEC 08 2008

WATER RESOURCES DEPT
SALEM, OREGON

0 400 Feet



Note: This map for water right purposes only.
Not to be used for property line location.

SURVEY BY:



TIMBERLINE
LAND SURVEYING
INCORPORATED

KERRY K. BRADSHAW L.S. 2271
P.O. BOX 3064
CENTRAL POINT OREGON 97502
(541)664-2878