


T.13S.,R.31E.,W.M.

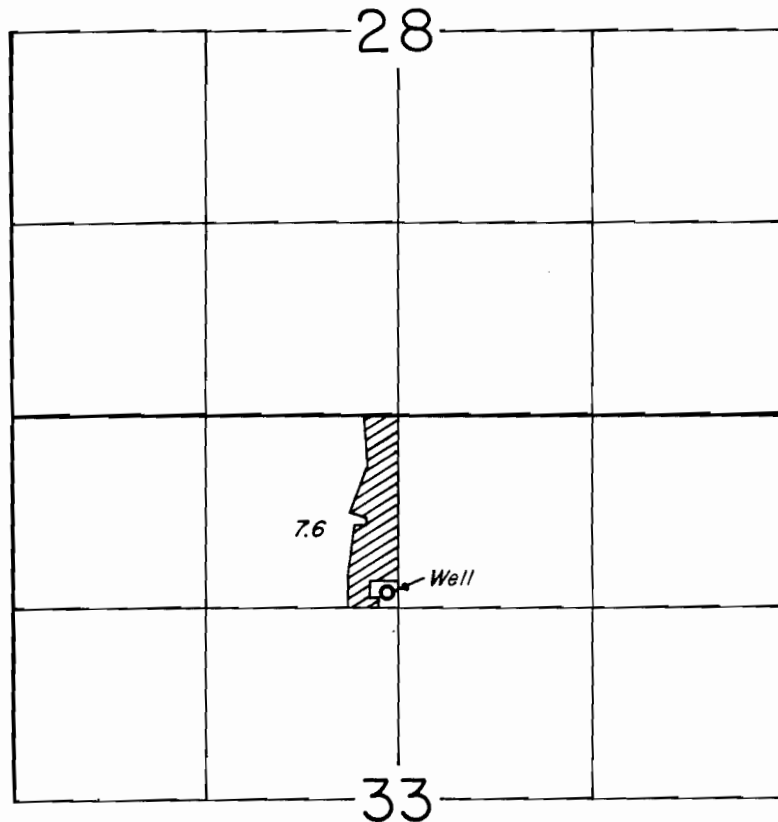

Well Loc.: 1200 ft S. & 80 ft W. from the N $\frac{1}{4}$ Corner Section 33

FINAL PROOF SURVEY
UNDER

Application No. G-8706 Permit No. G-8034
IN NAME OF

CHARLES D. AUFFORTH

Surveyed AUG. 26, 1981, by *dlb*