


T. 23S. R. 31E. W. 4M.

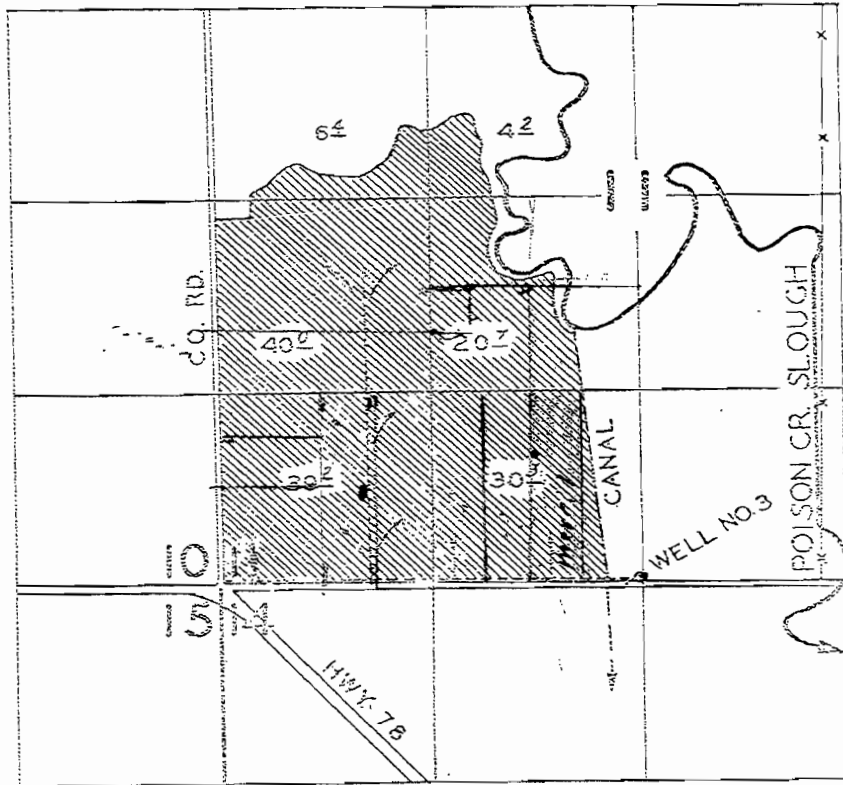

N
↑
1" = 1320'

FINAL PROOF SURVEY
UNDER

RECEIVED

MAY 16 2008

**WATER RESOURCES DEPT
SALEM, OREGON**

Application No. G299 Permit No. G297
IN NAME OF

RILEY & SEWELL

Surveyed OCT. 26, 1960, by C. O. BARTELS.

T 10634