

SECTION 31, TWP.2 N. RANGE 13 E. W.M.

WASCO COUNTY, OREGON

N.1/4

30 29
31 32

RECEIVED SECTION CORNER

OCT - 3 1997

WATER RESOURCES DEPT.
SALEM, OREGON

N. W. 1 / 4, N. E. 1 / 4

N. E. 1 / 4, N. E. 1 / 4

NO TYPE WELLS #1 & #3 NOT DEVELOPED

SHOULD BE WELL #1

EXIST. WELL #3
CAPPED.

S. W. 1 / 4, N. E. 1 / 4
7.0 AC.

EXIST. WELL #2
ELEV. 835± MSL
N.315.23' & W.2155.60
FROM E.1/4, SEC. 31

S. E. 1 / 4, N. E. 1 / 4

TRACK ROAD

140' EXIST. ROAD

2155.60'

EXIST. WELL #3
CAPPED.

C.1/4 COR.
SEC. 31

HAWLEY STEEL ROAD

B.P.A.
TRANSMISSION LINE

E.1/4 CORNER
14"x14"x20" STONE
"W.1/4" ON FACE.

PLANTED ORCHARD
AREA. 2.4 AC±

PASTURE AREA
4.6 AC±

TOTAL AREA= 7.0 AC.

WATER RIGHT FINAL PROOF SURVEY

SCALE: 1"= 400'


CERTIFICATE No. G-12452

PERMIT No. G-11399

IN THE NAME OF:
JAMES & LORETTA ELLETT, H.&W.

DATE: SEPTEMBER 27, 1997

BY: TENNESON ENGINEERING CORP.
409 LINCOLN STREET,
THE DALLES, OREGON. 97058
PH. 541-296-9177
FAX 541-296-6657

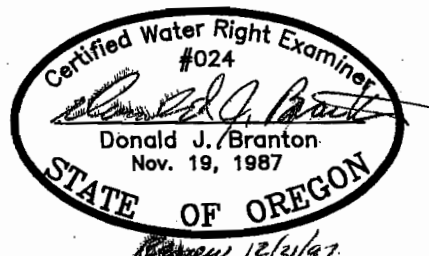

NOTE:

"THIS MAP IDENTIFIES THE LOCATION OF THE WATER RIGHT ONLY AND IS NOT INTENDED TO PROVIDE DIMENSIONS OR LOCATE PROPERTY OWNERSHIP LINES."

W.O. #7382