


T. 32&33 S., R. 17 E., W.M.

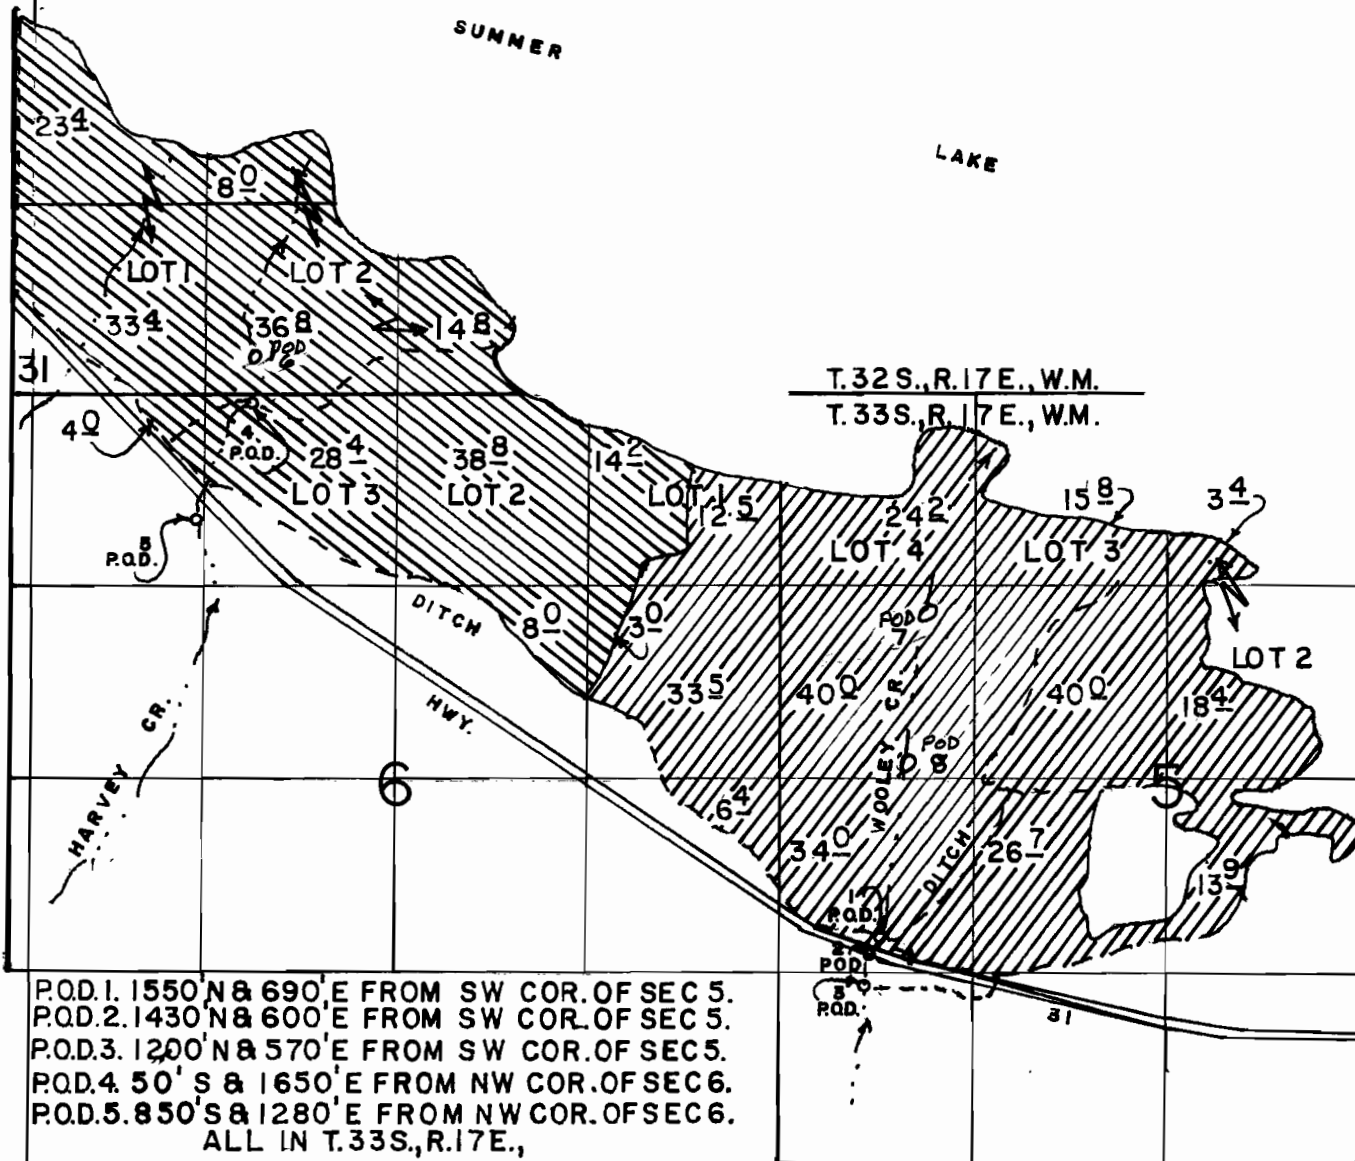

SCALE: 1" = 1320'



HARVEY CR.



WOOLEY CR.

FINAL PROOF SURVEY

UNDER

Application No. 66900 Permit No. 47968
IN NAME OF

HARVEY RANCH, INCORPORATED

Surveyed APRIL 11, 1994, by R.M. SUTTERFIELD

POD 6 - 200' N & 1000' W FROM S 1/4 COR, SEC 31

POD 7 - 1100' N & 1000' E FROM W 1/4 COR, SEC 5

POD 8 - 50' N & 900' E FROM W 1/4 COR, SEC 5

Amended by WRD Staff - 4/10/2009 & 6/8/2009

PHOTO SURVEY 41035-379-286 R

12/27/94

R.M.S.