

RECEIVED


SEP 26 1997

WATER RESOURCES DEPT.
SALEM, OREGON


FINAL PROOF SURVEY

APPLICATION NO. G-12512
PERMIT NO. G-11566

IN THE NAME OF
IRV GIVOT

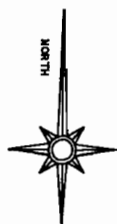


9-04-97

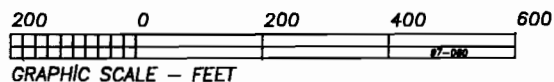

GRAPHIC SCALE - FEET

T14S, R11E, W.M.
DESCHUTES CO., OR

N/4 CORNER
SEC. 28

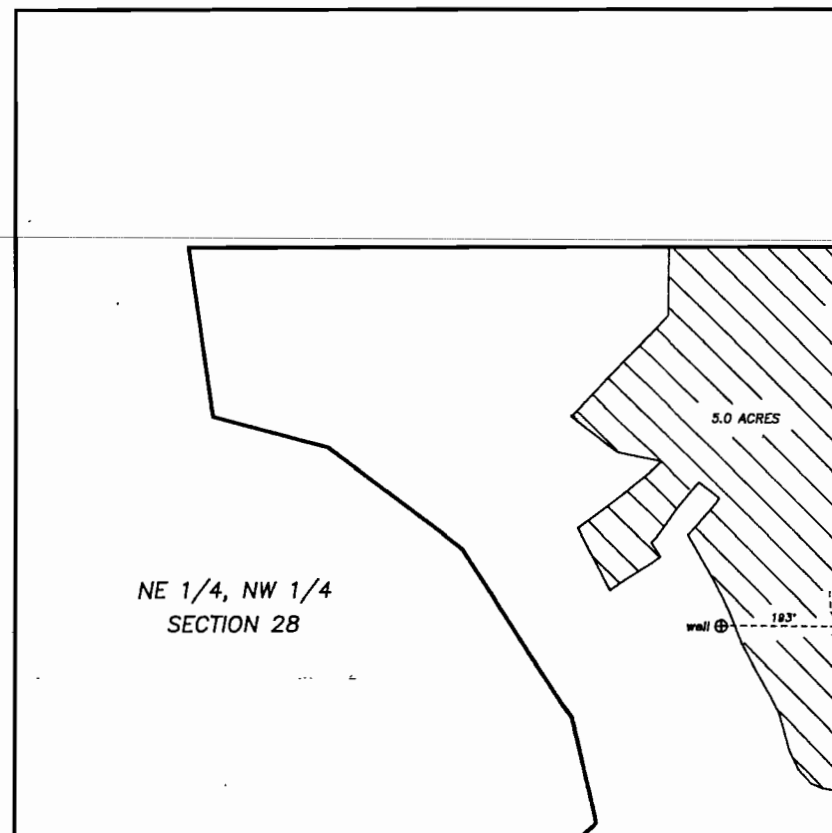

Fred A. Ast, Jr. and Associates

250 W. Cascade Avenue

P.O. Box 751

Sisters, OR 97759

541-549-7851