


T2S., R4E., W.M.

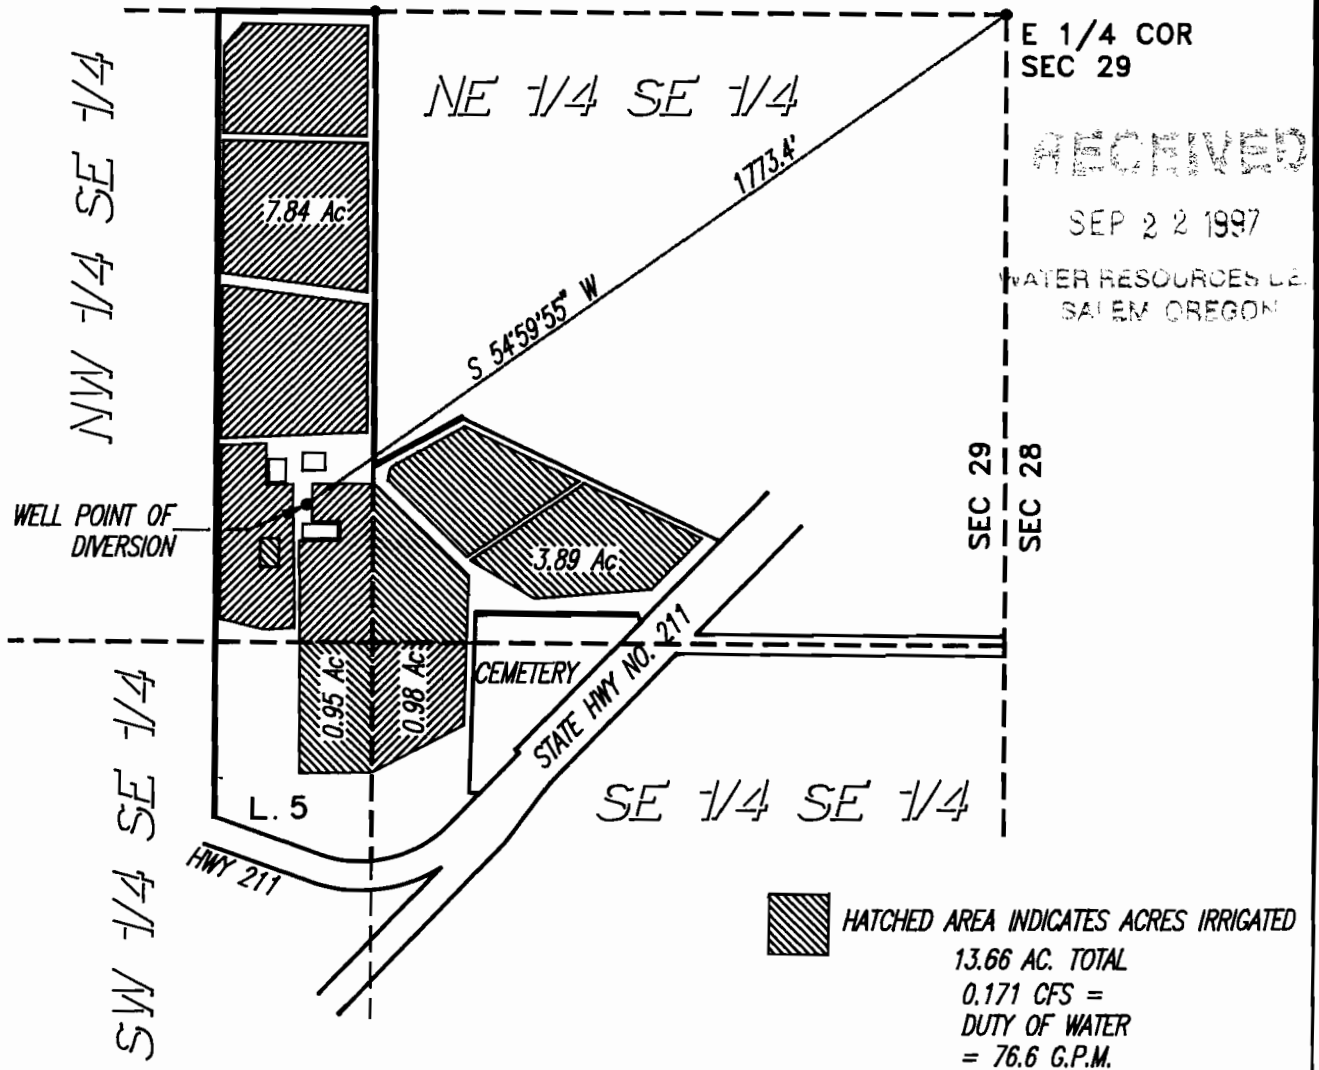

FINAL PROOF SURVEY

UNDER

Application No. G-12704 Permit No. G-12354



IN NAME OF

MARK B. & AMY D. ERICKSON

Surveyed AUGUST 28, 1997, by A.M. KLEIN



SCALE: 1" = 400'

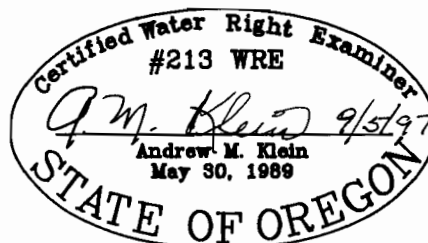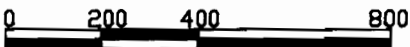

EXPIRES 06/30/99

AMENDED 6/12/09 WRD-LN
THIS MAP IS FOR THE PURPOSE
OF IDENTIFYING THE LOCATION OF
THE WATER RIGHT ONLY AND IS
NOT INTENDED TO PROVIDE LEGAL
DIMENSIONS OR THE LOCATION
OF PROPERTY OWNERSHIP LINES.