


FINAL PROOF SURVEY

UNDER APPLICATION #G-12011 PERMIT #G-11083
 SITUATED IN THE W1/2 NW1/4 AND SE1/4 NW1/4 OF SECTION 30,
 T39S, R10EWM, KLAMATH COUNTY, OREGON
 DECEMBER 1992

MAP PREPARED FOR
 -- KLAMATH COUNTY SCHOOL DISTRICT --

MAP PREPARED FROM
 -- MAP OF APPLICATION #G-12011 --
 -- ASSESSORS MAP --
 -- FIELD INSPECTION --

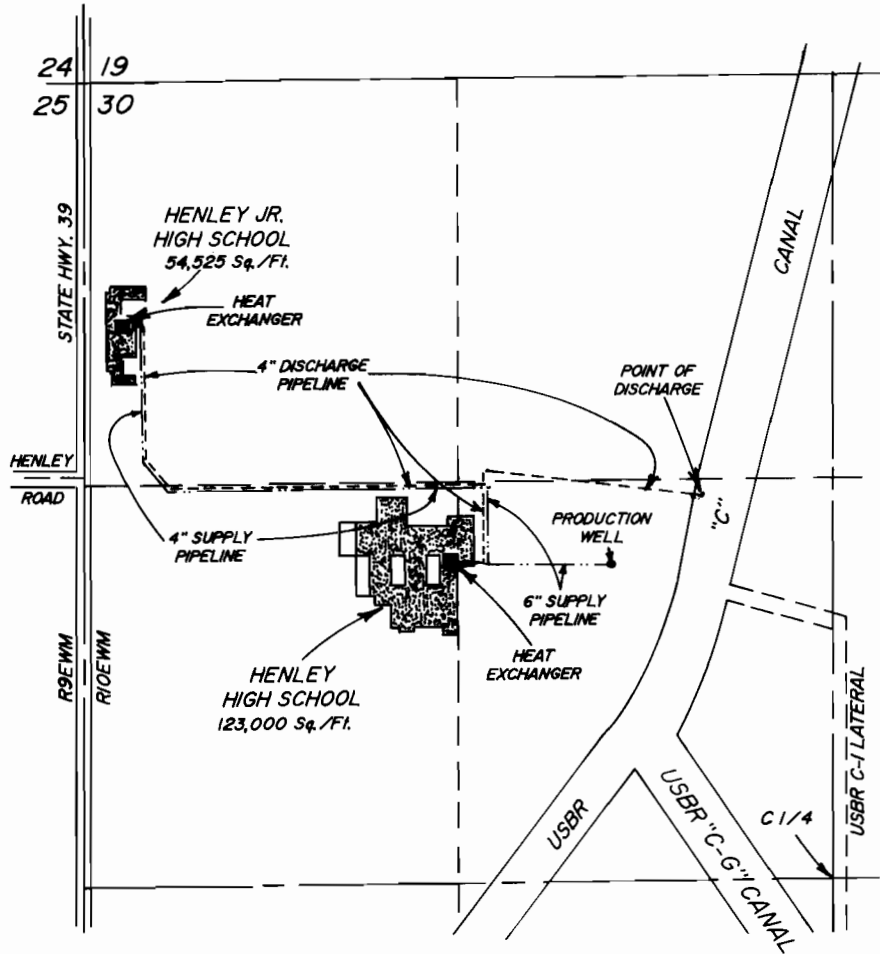


LOCATION OF PRODUCTION WELL BY FIELD INSPECTION

1600 FEET SOUTH AND 1850 FEET EAST OF
 THE NORTHWEST CORNER OF SECTION 30

LOCATION OF POINT OF DISCHARGE BY FIELD INSPECTION

1435 FEET SOUTH AND 2150 FEET EAST OF
 THE NORTHWEST CORNER OF SECTION 30

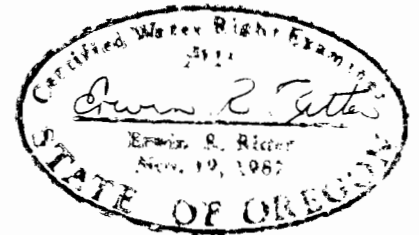

AREA TO BE HEATED 177,525 Sq./Ft.

THE PURPOSE OF THIS MAP IS TO IDENTIFY THE LOCATION OF THE
 WATER RIGHT. IT IS NOT INTENDED TO PROVIDE INFORMATION RELATIVE
 TO THE LOCATION OF PROPERTY OWNERSHIP BOUNDARY LINES.

TRU-LINE SURVEYING
 2333 SUMMERS LANE
 KLAMATH FALLS, OR. 97603