


T. 17 S., R. 1 W., S. 33, W.M.

The purpose of this map is to identify the location of the water right. It is not intended to provide information relative to the location of property ownership boundary lines.

RECEIVED

SEP 15 1998

WATER RESOURCES DEPT.  
SALEM, OREGON

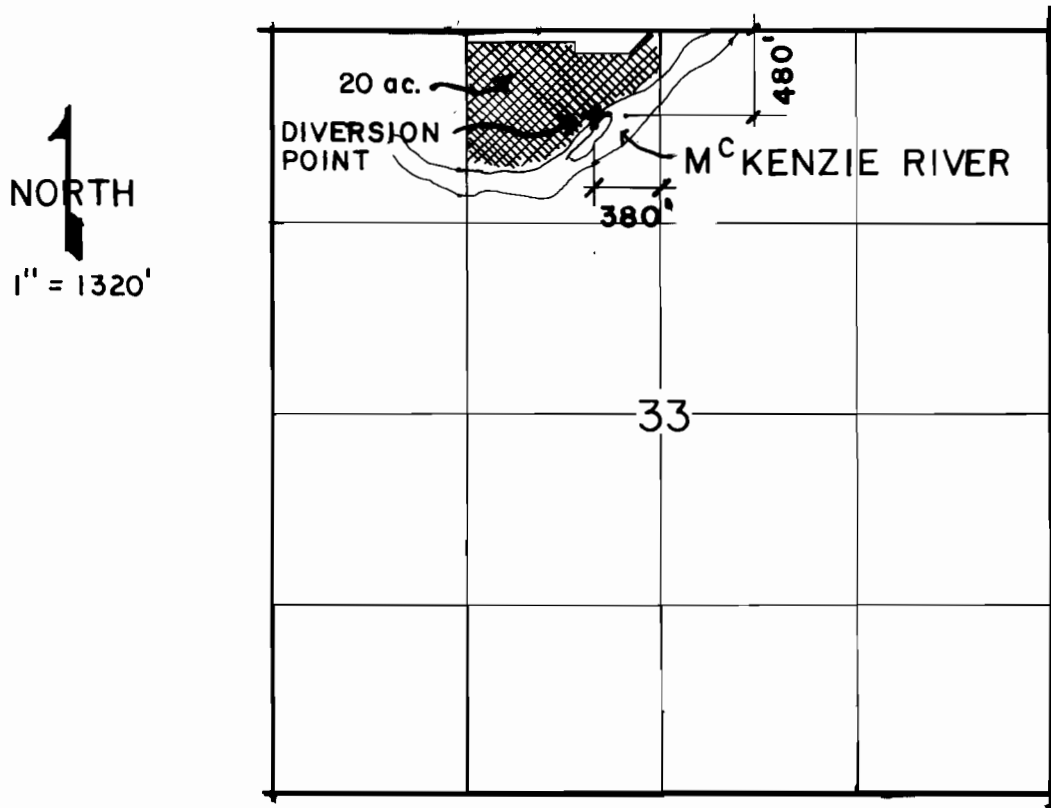

FINAL PROOF SURVEY

UNDER

Application No. 72054

Permit No. 51642

IN NAME OF

JOSEPH LAMONT



SURVEY BY OWEN GROVER JR., C.W.R.E.

RICK RALSTON

DATE AUG. 20, 1998