


# T.7S.R.3 & 4 W.W.M.

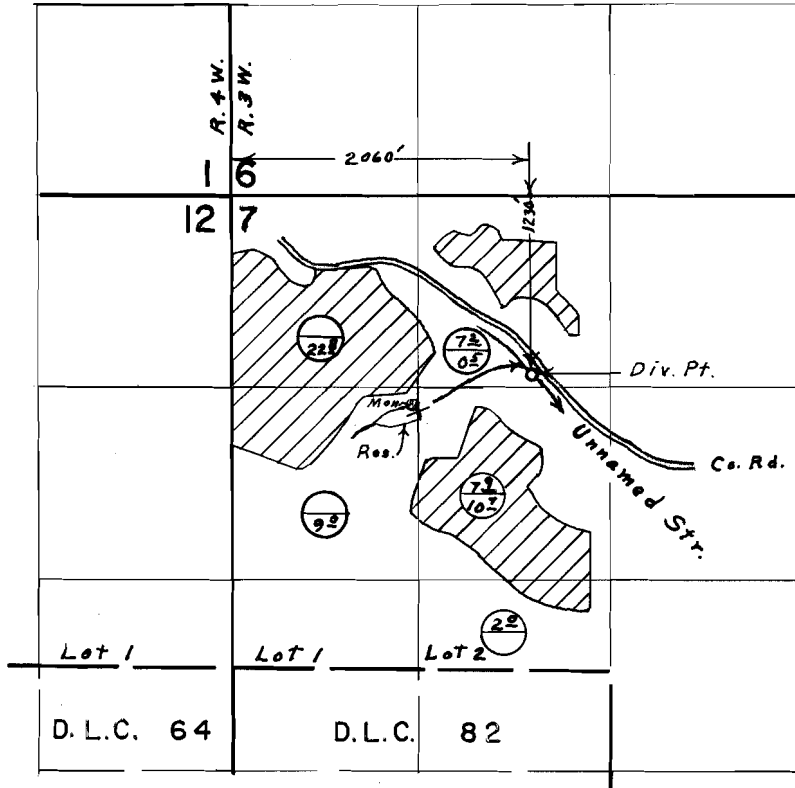

Primary  
Supplemental ⊖

## FINAL PROOF SURVEY UNDER

Application No. 43569 Permit No. 32583  
IN NAME OF

FRED L. MEYER

Surveyed April 5, 1972, by L. E. Gould