


T.7S. R.3W.W.M.

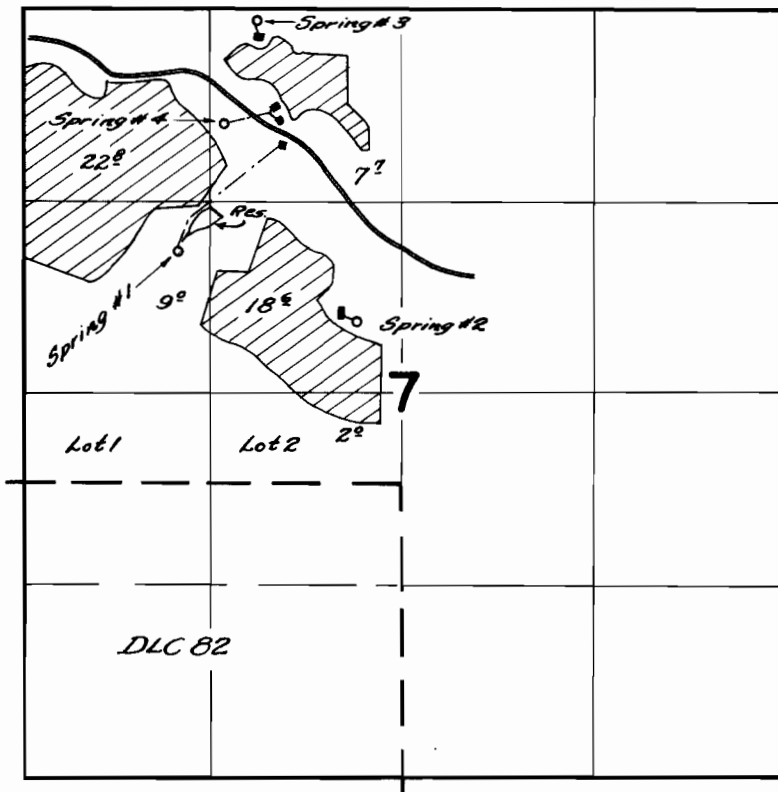

**FINAL PROOF SURVEY**  
UNDER

Application No. *R-28532* 27159 Permit No. *R-1526* 22419  
IN NAME OF

*FRED L. MEYER*

Surveyed *March 19* 19.59, by *C.O. Bartels*