


T.19S. R.1W.W.M.

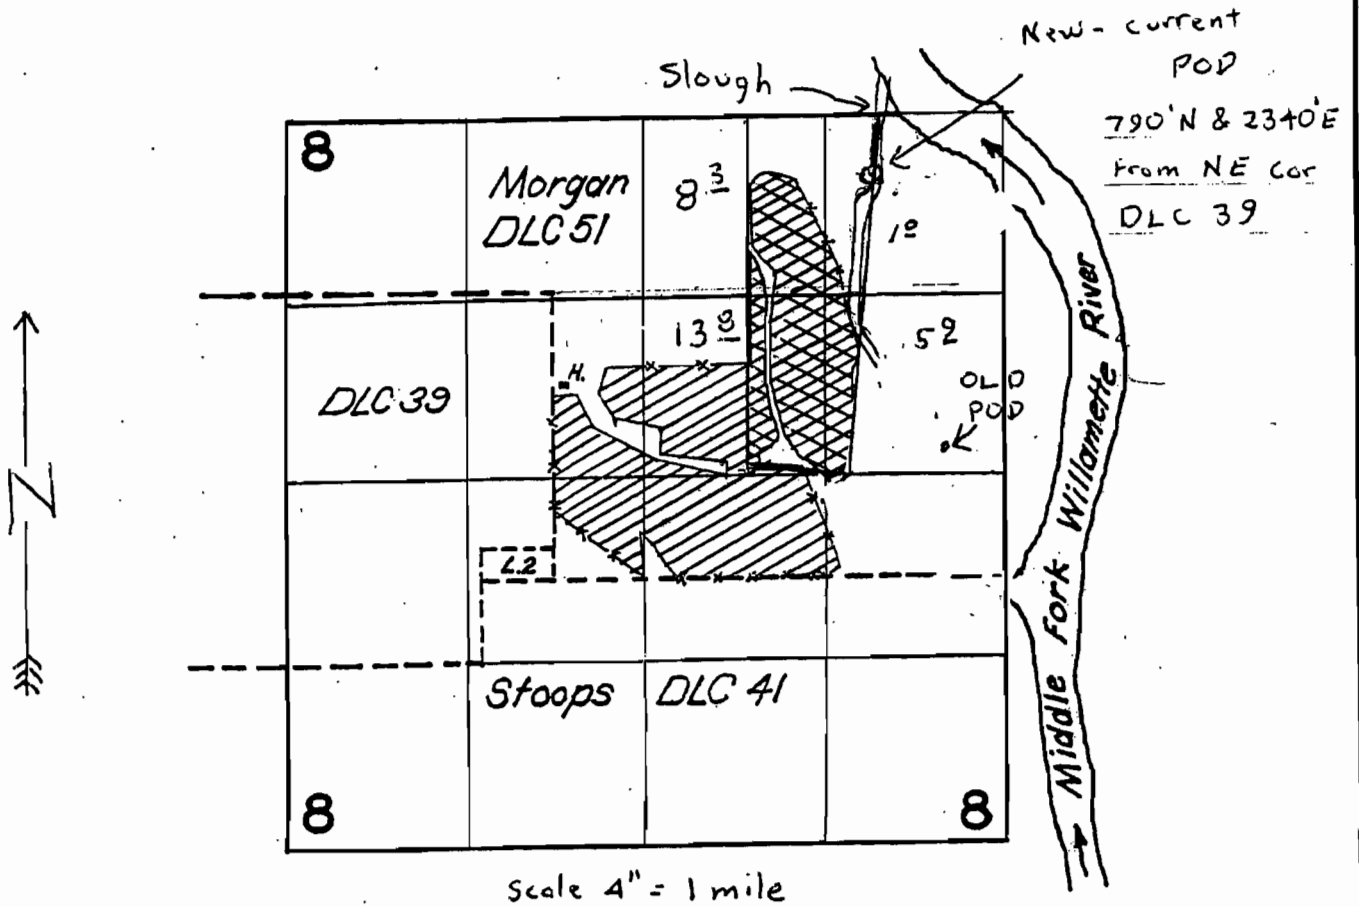

Historical Point of Diversion Change



*Affecting These Lands

All on TL 10.3

RECEIVED

OCT 29 2007

WATER RESOURCES DEPT
SALEM, OREGON

Permit S-25217
cert 44405