


RECEIVED

SEP 29 1998

WATER RESOURCES DEPT.
SALEM, OREGON

T.32S.,R.2E.,W.M.

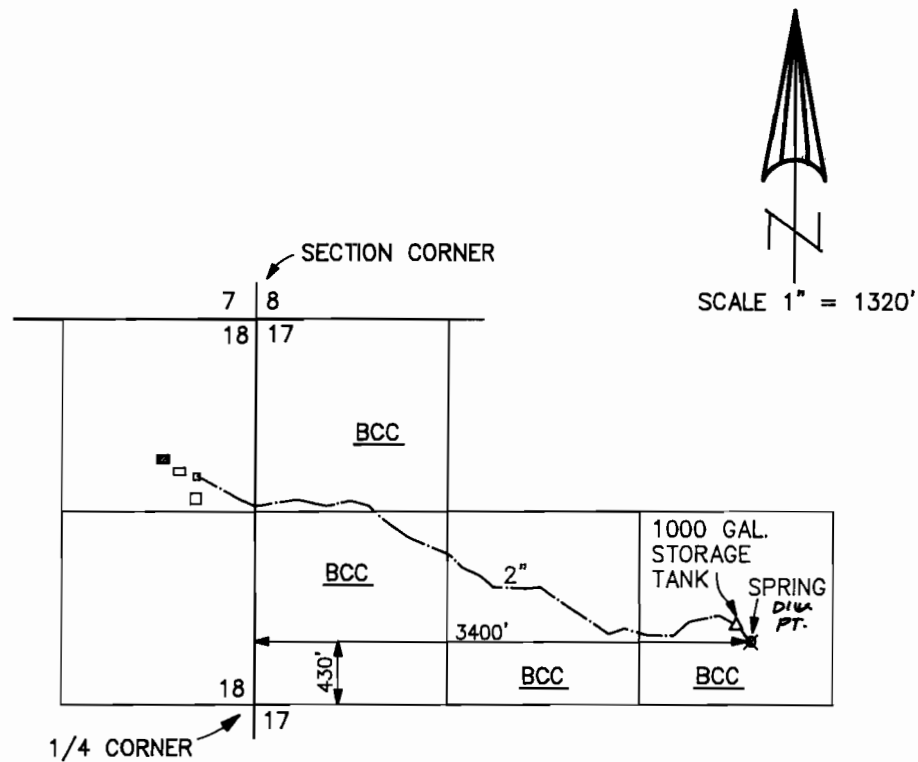

FINAL PROOF MAP

APPLICATION No. S-80632
PERMIT No. 52708

IN THE NAME OF
DONALD R. NELSON

NOTE: MAP PREPARED FOR
WATER RIGHT PURPOSES ONLY,
NOT FOR PROPERTY BOUNDARY
LOCATIONS.

MAP PREPARED SEPTEMBER 16, 1998 BY GARY D. KAISER

