


T.1S., R.4E., W.M.
SECTION 17

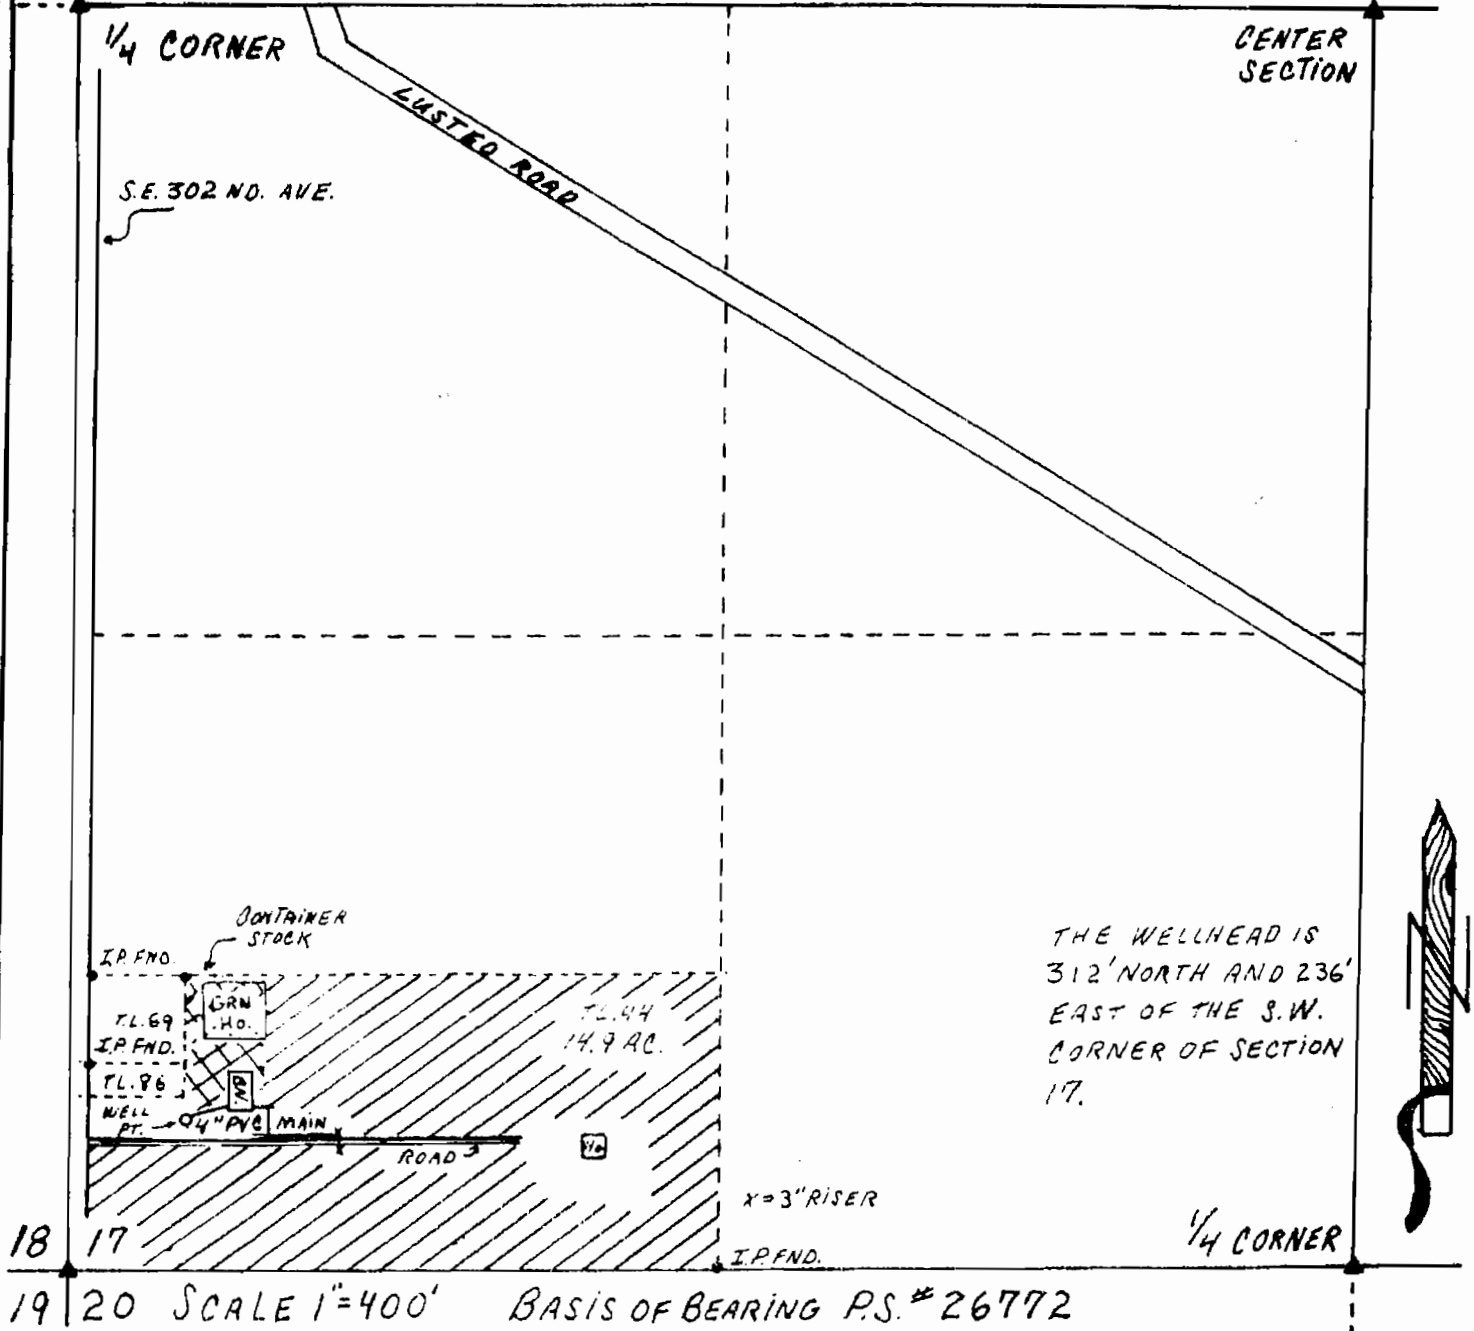

THE WELLHEAD IS
312' NORTH AND 236'
EAST OF THE S.W.
CORNER OF SECTION
17.

RECEIVED FINAL PROOF SURVEY

UNDER

JAN - 5 1998 APPLICATION # G-13172 PERMIT # G-12015

IN THE NAME OF

CRAIG SPINKS

SURVEYED Oct. 20, 1997 By PATRICK J. HINDS

WATER RESOURCES DEPT.
SALEM, OREGON

