


T. 11S., R. 43E., W.M.

RECEIVED


JAN - 6 1935

WATER RESOURCES DEPT.  
SALEM, OREGON

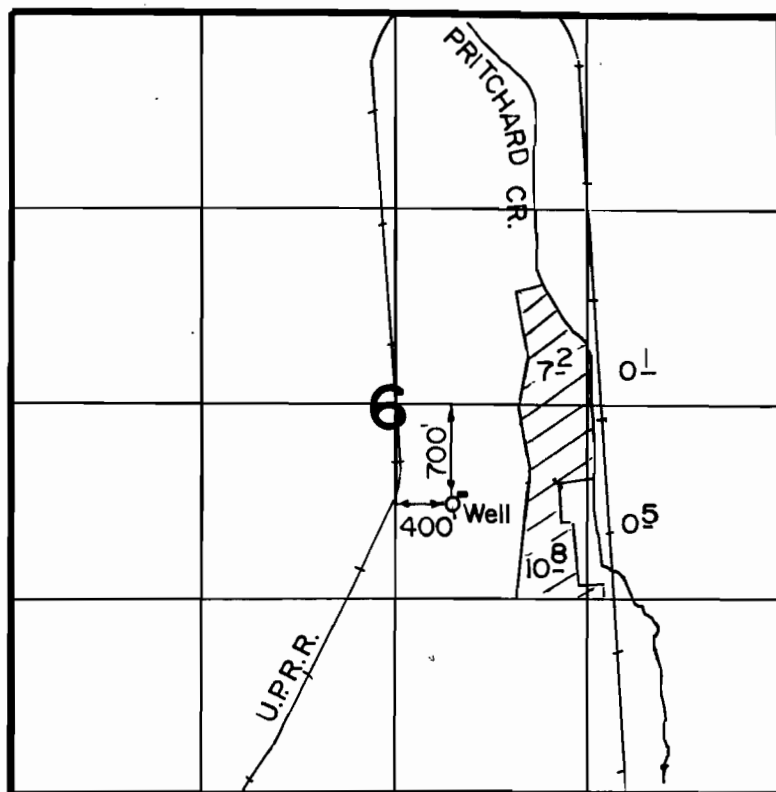

SCALE 1" = 1320'

The purpose of this map is for identifying the location of the water right only and is not intended to provide legal dimensions of property ownership lines.

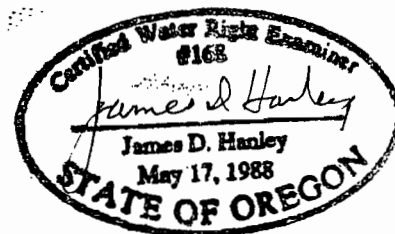

**FINAL PROOF SURVEY**  
UNDER

APPL. G-13764

PER. G-12701

IN NAME OF

JACK PALMER

Surveyed Nov. 30, 1997